

MISSISSIPPI DEPARTMENT OF NATURAL RESOURCES

Bureau of Land and Water Resources

Southport Mall

P.O. Box 10631

Jackson, Mississippi 39209

WATER WELL DRILLERS LOG

Sharkey  
B 42  
5/18/82

CODED

Sharkey

Humphrey

Shreve

✓ 7/12/82  
 date well completed

Dyer well & Irrig. Serv.  
 firm name

county well located

LANDOWNER David Greer

description of formations encountered	from	to
<u>Clay</u>	<u>0</u>	<u>28</u>
<u>fine sand</u>	<u>28</u>	<u>40</u>
<u>sand</u>	<u>40</u>	<u>66</u>
<u>sand &amp; gravel</u>	<u>66</u>	<u>113</u>

(mailing address)

WELL LOCATION:

sec. 9 T. 14 N. R. 5 E.  
3 miles SW of Delta City  
 (distance) (direction) (nearest town)

WELL PURPOSE:  
 (home, irrigation, municipal, industrial)

WELL COMPLETION DATA:

- (1) diameter (inches) 12
- (2) total depth (feet) 113
- (3) static water level (feet) 18 below above top of ground.
- (4) casing Steel, 803,  
 (material) (depth)  
12 if telescope see back.  
 (size)
- (5) screen 40, 93  
 (length) (depth to top)  
12, Mild Steel  
 (size) (material)
- (6) pump 30, 1500  
 (HP) (yield gpm)  
Electric  
 (type power)
- (7) electric log No  
 (yes or no)

(organization running log)

(8) how well bottom plugged Plate

DRILLERS REMARKS:

CODED

CODED


DEPT. OF NATURAL RESOURCES  
 BUREAU OF LAND & WATER RESOURCES

SEP 30 1982

RECEIVED

If well telescopes please sketch and show depths.

GROUND LEVEL

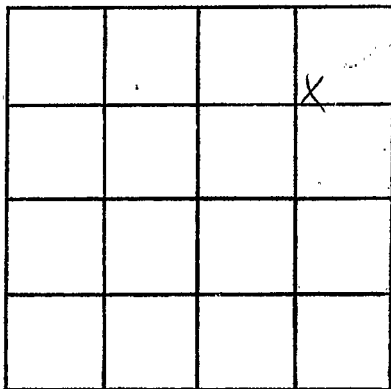

SECTION 9

Please indicate well location X.

ADDITIONAL INFORMATION

If more than one screen, show locations of each on sketch.