

MISSISSIPPI DEPARTMENT OF NATURAL RESOURCES

Bureau of Land and Water Resources

Southport Mall

P.O. Box 10631

Jackson, Mississippi 39209

WATER WELL DRILLERS LOG

CODED

Sharkey  
B 43  
4/29/82

4/29/82  
date well completed

Superwell  
firm name

Sharkey  
Humphrey  
county well located

LANDOWNER: David Green

description of formations encountered

from

to

(mailing address)

<u>Clay</u>	<u>0</u>	<u>28</u>
<u>fine sand</u>	<u>28</u>	<u>35</u>
<u>Sand</u>	<u>35</u>	<u>48</u>
<u>Sand &amp; gravel</u>	<u>48</u>	<u>111</u>

WELL LOCATION:

sec. 4 T. 14 N. R. 5 E.  
S. 12 W. W.  
4 miles W of Delta, Ct  
(distance) (direction) (nearest town)

WELL PURPOSE:

(home, irrigation, municipal, industrial)

WELL COMPLETION DATA:

- (1) diameter (inches) 16"
- (2) total depth (feet) \_\_\_\_\_
- (3) static water level (feet) 15 below above top of ground.
- (4) casing Steel 71,  
(material) (depth)  
16" if telescope see back.  
(size)
- (5) screen No. 71  
(length) (depth to top)  
16, rod steel  
(size) (material)
- (6) pump 40 1800  
(HP) (yield gpm)  
Electric  
(type power)
- (7) electric log No  
(yes or no)  
None  
(organization running log)
- (8) how well bottom plugged Plate

CODED

DEPT. OF NATURAL RESOURCES  
BUREAU OF LAND & WATER RESOURCES


SEP 30 1982

RECEIVED

DRILLERS REMARKS:

If well telescopes please sketch and show depths.

GROUND LEVEL

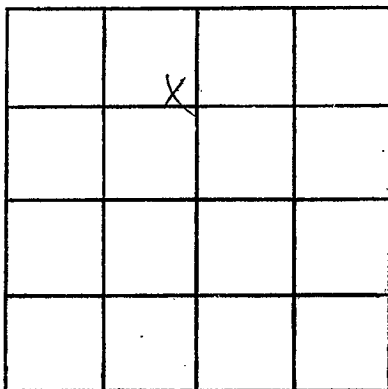

SECTION H

Please indicate well location X.

ADDITIONAL INFORMATION

If more than one screen, show locations of each on sketch.