

MISSISSIPPI DEPARTMENT OF NATURAL RESOURCES
Bureau of Land and Water Resources
 Southport Mall
 P.O. Box 10631
 Jackson, Mississippi 39209
WATER WELL DRILLERS LOG

102
CODED

Shankey
B 44
4-28-83

April 28, 1983 date well completed Larry's well pump firm name Shankey county well located

LANDOWNER: <u>David Phillips</u>	description of formations encountered	from	to
<u>Anguilla mo.</u> (mailing address)	<u>slay</u>	0	20
WELL LOCATION: sec. <u>31</u> T- <u>14</u> N S R- <u>5</u> E W <u>3 E</u> miles <u>4W</u> of <u>Anguilla</u> (distance) (direction) (nearest town)	<u>Scam</u>	20	50
WELL PURPOSE: (home, irrigation, municipal, industrial)	<u>Sand + gravel</u>	50	140
WELL COMPLETION DATA: (1) diameter (inches) <u>4" x 2"</u>	<u>slay</u>	140	220
(2) total depth (feet) <u>620</u>	<u>slay + sand</u>	220	540
(3) static water level (feet) <u>24</u> below top of ground.	<u>Sand</u>	540	620
(4) casing <u>plastic</u> , <u>580</u> , (material) (depth)			
(5) screen <u>46</u> , <u>580</u> (length) (depth to top)			
(6) pump <u>3</u> , <u>60</u> (HP) (yield gpm)			
(7) electric log <u>No.</u> (yes or no)			
(8) how well bottom plugged <u>PVC cap</u>			
DRILLERS REMARKS:			

CODED


DEPT. OF NATURAL RESOURCES
 BUREAU OF LAND & WATER RESOURCES

SEP 20 1983

RECEIVED

If well telescopes please sketch and show depths.

GROUND LEVEL

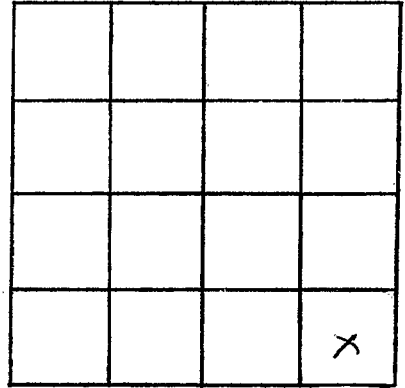

SECTION 31

Please indicate well location X.

ADDITIONAL INFORMATION

If more than one screen,
show locations of each on sketch.