

MISSISSIPPI DEPARTMENT OF NATURAL RESOURCES

Bureau of Land and Water Resources

Southport Mall

P.O. Box 10631

Jackson, Mississippi 39209

CODED

WATER WELL DRILLERS LOG

B46
 SHARKEY CO.
 2-22-84

Feb 22 1984 Harris well & pump SHARKEY
 date well completed firm name county well located

LANDOWNER: Vernon Phillips

description of formations encountered

from to

Anguilla, Mo
 (mailing address)

Clay	0	35
Sand	35	190
Sand	190	240
Clay	240	300
Sand	300	340
Clay	340	390
Sand	390	460
Clay	460	490
Sand	490	640

WELL LOCATION:

sec. 24 T. 14 N. R. 5 E.
13 miles N-E of Anguilla
 (distance) (direction) (nearest town)

WELL PURPOSE:
 (home, irrigation, municipal, industrial)

WELL COMPLETION DATA: 120' - 4"

- (1) diameter (inches) 4x2"
- (2) total depth (feet) 650
- (3) static water level (feet) 27' below above top of ground.
- (4) casing PVC, 600
 (material) (depth)
- 4x2 if telescope see back.
 (size)
- (5) screen 40', 600-640
 (length) (depth to top)
- .010, 2" PVC
 (size) (material)
- (6) pump 3/4, 18
 (HP) (yield gpm)
- E-220
 (type power)
- (7) electric log NO
 (yes or no)

(organization running log)


(8) how well bottom plugged Sand
Slack

DRILLERS REMARKS:

1-18-85
 JFW

If well telescopes please sketch and show depths.

GROUND LEVEL

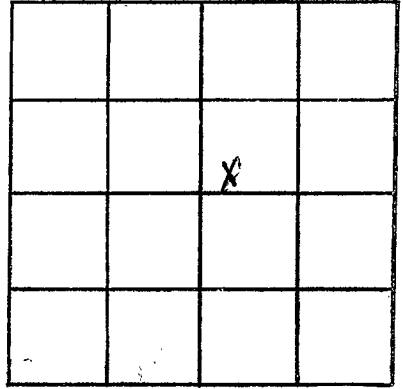

SECTION 14

Please indicate well location X.

ADDITIONAL INFORMATION

If more than one screen,
show locations of each on sketch.