

SHARKEY
B49

MISSISSIPPI DEPARTMENT OF NATURAL RESOURCES
Bureau of Land and Water Resources
Southport Mall
P.O. Box 10631
Jackson, Mississippi 39209
WATER WELL DRILLERS LOG

CODED

6-24-85 19 Larrys Wells Pump Sharkey
date well completed firm name county well located

LANDOWNER: Aycock Farms

description of formations encountered

from	to
0	25
25	56
56	116

Belzoni, ms.
(mailing address)

clay
fine sand
coarse sand

WELL LOCATION:

sec 24 T 14 N R 5 E
5 miles W of Andrite
(distance) (direction) (nearest town)

CODED

WELL PURPOSE:

(home, irrigation, municipal, industrial)

WELL COMPLETION DATA:

- (1) diameter (inches) 12"
- (2) total depth (feet) 116'
- (3) static water level (feet) 22' below above top of ground.
- (4) casing steel, 76'
(material) (depth)

(size) if telescope see back.

- (5) screen 40', 76'
(length) (depth to top)
12", steel
(size) (material)


- (6) pump _____ (HP) _____ (yield gpm)

(type power)

- (7) electric log NO
(yes or no)

(organization running log)

- (8) how well bottom plugged steel plate

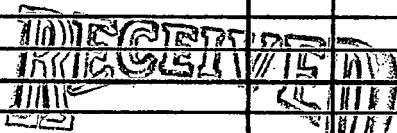

JUN 23 1985

Department of Natural Resources
Bureau of Land and Water Resources

DRILLERS REMARKS:

