

MISSISSIPPI DEPARTMENT OF NATURAL RESOURCES

Bureau of Land and Water Resources

Southport Mall

P.O. Box 10631

Jackson, Mississippi 39209

WATER WELL DRILLERS LOG

Permit Applied For B 50

5-16-88 date well completed 1988 Dyer Well firm name Sharkey county well located

LANDOWNER: Michael King  
 Rt 1 Box 170  
 Anguilla, Ms. 38721  
 (mailing address)

description of formations encountered	from	to
Clay	0	30
Fine Sand	30	60
M Sand + Gravel	60	74
Sand + Gravel	74	85
Fine Sand	85	100
Sand + Gravel	100	112
Fine Sand	112	117
Sand + Gravel	117	119

WELL LOCATION:  
 sec. 23 T 14 N R 5 E S W

(distance) miles (direction) of (nearest town)

WELL PURPOSE: sub pond  
 (home, irrigation, municipal, industrial)

WELL COMPLETION DATA:

- (1) diameter (inches) 16"
- (2) total depth (feet) 119'
- (3) static water level (feet) \_\_\_\_\_ below/above top of ground.
- (4) casing steel (material), \_\_\_\_\_ (depth),  
 16" (size) if telescope see back.
- (5) screen 40' (length), \_\_\_\_\_ (depth to top),  
 16" (size), \_\_\_\_\_ (material)
- (6) pump 60 (HP), \_\_\_\_\_ (yield gpm),  
 Gear (type power)
- (7) electric log No (yes or no),  
 None (organization running log)
- (8) how well bottom plugged Plate.


RECEIVED  
 JUN 06 1988

Department of Natural Resources  
 Bureau of Land & Water Resources

DRILLERS REMARKS:

If well telescopes please sketch and show depths.

GROUND LEVEL

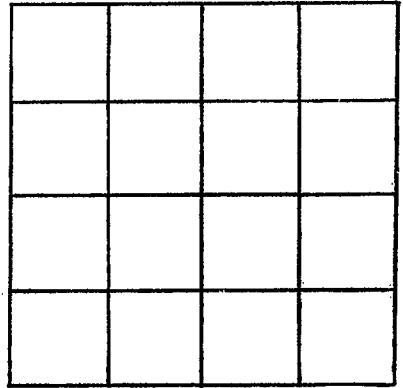

SECTION \_\_\_\_\_

Please indicate well location X.

ADDITIONAL INFORMATION

If more than one screen,  
show locations of each on sketch.