

33-02-08
90-45-14

MISSISSIPPI DEPARTMENT OF ENVIRONMENTAL QUALITY

COUNTY WELL LOCATED
Sharkey

WELL NUMBER **B-65** CODED

DATE WELL COMPLETED
2-8-01

PERMIT NUMBER

NAME OF DRILLING FIRM
Irrigation Equipment Inc.

Indianola, MS

Office of Land and Water Resources

P. O. Box 10631
Jackson, MS 39289-0631
WATER WELL DRILLERS LOG

NAME & MAILING ADDRESS OF LANDOWNER
Hollingsworth & Co.

Box 248

Hollandale, MS 38748

WELL LOCATION: SEC TOWNSHIP RANGE
ne/nw 30 14N S 5W W

DISTANCE DIRECTION NEAREST TOWN
_____ Mi. _____ of _____

OTHER LANDMARK

WELL PURPOSE: Home, Irrigation, Municipal, Industrial, Fish Pond, etc.
Irrigation

PUMP DATA

PUMP TYPE (Circle One):
Submersible, **Turbine** Jet Flowing Well,
Other (Describe) _____

POWER TYPE (Circle One):
Electric Tractor, Diesel, Gasoline, Butane,
Other (Describe) _____ H/P **60**

Pump Capacity (GPM) No. of Stages Setting Depth
2500 to 3000 1 70 FT.

PUMP TEST

Well yielded _____ GPM with
a drawdown of _____ ft.
after _____ hours of pumping

WELL DATA

Well Depth 125	Casing Diameter (In.) 16	Casing Length (Ft.) 75
Type of Casing pvc	Hole Depth 125	Depth to Static Water Level 19ft.

TYPE OF COMPLETION: (Circle One or More):
Gravel Packed, Underreamed, Telescoped,
Natural Development, Open Hole, Other
(Describe) _____

WELL GROUTED TO A DEPTH OF _____ FEET
Type Grout (circle one): Cement, Bentonite, or Mix

LOG DATA

TYPE OF LOG RUN (Circle One):
No Log Run, Electric, Gamma Ray, Density, Sonic, Neutron,
Other (Describe) _____

Name of Organization Running Log

SCREEN DATA

Diameter - Inches 16	Length - Feet 50	Slot Size - Inches .050
Screen Type pvc	Depth to Bottom - Feet 125	

GEOLOGIC DATA (Office Use Only)

Surface Elev.	Geologic Unit	Unit Thickness	Depth to Top
Subs. SWL	Date	Analysis	Aquifer Test

Driller's Remarks

Top of Lap Pipe or Reduction in Casing

FEET IF TELESCOPED OR MORE THAN ONE SCREEN: USE BACK PAGE

DESCRIPTION OF FORMATIONS ENCOUNTERED	FROM	TO
Clay	0	25
Fine Sand	25	45
Med. Sand	45	85
Coarse Sand	85	95
Coarse Sand/Gravel	95	105
Small Gravel	105	115
Coarse Sand/Gravel	115	125


FORMATIONS (Continued)	FROM	TO

REC'D MAY 29 2001

IF MORE SPACE IS NEEDED, USE BACK

If well telescopes please
sketch and show depths.

GROUND LEVEL

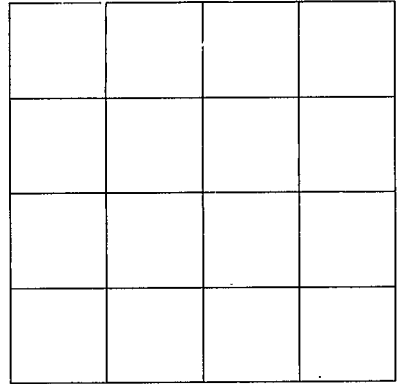

SECTION _____

Please indicate well location X.

ADDITIONAL INFORMATION

If more than one screen,
show location of each on sketch.