

COUNTY WELL LOCATED
SHARKEY
 WELL NUMBER CODED
B-12
 DATE WELL COMPLETED
7-2-01

Craig Boykin MISSISSIPPI DEPARTMENT OF ENVIRONMENTAL QUALITY
 33-03-25 90-45-18

Office of Land and Water Resources

P. O. Box 10631
 Jackson, MS 39289-0631

Chicot Irrigation, Inc. WATER WELL DRILLERS LOG

NAME & MAILING ADDRESS OF LANDOWNER

CRAIG BOYKIN
 c/o **CAINEY BAYOU FARMS**
 Rt. 1, Box 212, Rolling Fork, MS 39159

WELL LOCATION: SEC TOWNSHIP RANGE
18 14 N 5 E W

DISTANCE DIRECTION NEAREST TOWN
3.5 Miles **EAST** of **Delta City**

OTHER LANDMARK
New Power Line on Fish Lake Rd.

WELL PURPOSE: Home Irrigation Municipal, Industrial, Fish Pond, etc.

PUMP DATA

PUMP TYPE (Circle One):
 Submersible, **Turbine**, Jet, Flowing Well,
 Other (Describe)

POWER TYPE (Circle One):
 Electric, Tractor, **Diesel**, Gasoline, Butane,
 Other (Describe) H/P **60**

Pump Capacity (GPM) No. of Stages Setting Depth
2500 2 60 FT.

PUMP TEST
 Well yielded _____ GPM with
 a drawdown of _____ ft.
 after _____ hours of pumping

WELL DATA

Well Depth Casing Diameter (In.) Casing Length (Ft.)
105 16 65

Type of Casing Hole Depth Depth to Static Water Level
PVC 110

TYPE OF COMPLETION: (Circle One or More):
 Gravel Packed, Underreamed, Telescoped,
 Natural Development, Open Hole, Other
 (Describe)

WELL GROUTED TO A DEPTH OF _____ FEET
 Type Grout (circle one): Cement, Bentonite, or Mix

SCREEN DATA

Diameter - Inches Length - Feet Slot Size - Inches
16 40 051

Screen Type Depth to Bottom - Feet
PVC 105

LOG DATA

TYPE OF LOG RUN (Circle One): **No Log Run**,
 Electric, Gamma Ray, Density, Sonic, Neutron,
 Other (Describe)

Name of Organization Running Log

GEOLOGIC DATA (Office Use Only)

Surface Elev.	Geologic Unit	Unit Thickness	Depth to Top
Subs. SWL	Date	Analysis	Aquifer Test

Driller's Remarks

33' 02" 22

090 45 92


Top of Lap Pipe or Reduction in Casing
 FEET IF TELESCOPED OR MORE THAN ONE SCREEN: USE BACK PAGE

DESCRIPTION OF FORMATIONS ENCOUNTERED	FROM	TO	FORMATIONS (Continued)	FROM	TO
TOP SOIL	0	10			
Gray clay	10	38			
Fine sand	38	65			
Coarse sand & gravel	65	105			
gravel	105	110			

REC'D SEP 07 2001

If well telescopes please
sketch and show depths.

GROUND LEVEL

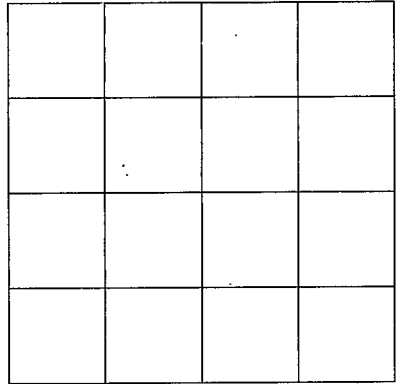

SECTION _____

Please indicate well location X.

ADDITIONAL INFORMATION

If more than one screen,
show location of each on sketch.