	Stata W	ell Report		
		art 1	For Office Use Only:	
County: Sharkey Mississi	—	t of Environmental Quality	Aquifer:	
	ffice of Land a	Well #: B-81		
Driller: Charles M. Aichols		Box 10631 IS 39289-0631	L. S. Elevation:	
Date drilling completed: 5-24-05		961-5210		
	(601)35	4-6938 (fax)	E-log #:	
State Law requires that this report be pro 30 days of completion of drilling of the wo		driller in detail and filed w	ith the Department within	
Well Owner Information		Wel	l Location	
Owner Name Albert Maha its		Latitude: 33 ° 03 '28	U' Longitude: 090 ° 45 ' 08 W	
Mailing Address: 10500 Hwy 14	WLGT	Method of Lat/Long (circle or	ne): Conventional Survey,	
A		USGS quad, Hand-held	GPS) Survey-grade GPS	
City State	71.59 Zip Code	<u>NE 14 NO 14 Sec 19</u>	18 Twn 141 Rng 50	
Telephone No. ()	-	Distance Direction	Nearest Town of <u>Delta City</u>	
	Well	Data		
		\bigcirc	.	
Purpose of Well (circle one) Home Industrial				
Date well drilling started: $5-24-05^{-1}$			-	
If flowing, method of flow regulation: Valve	Other (d	escribe)		
Static Water Level:feet above or bel	ow (circle one)	and surface Date measured:	5-24-05	
Method of Measurement (circle one)	electric tape	air line other:		
Hole depth: Well depth:	120	Well grouted to a depth of _	feet	
Type of grout (circle one): Cement Bentoni	ite Mix	$\mathbf{)}$		
Casing length: <u>\$0</u> feet Casing diamete	r: <u>16</u>	inches Type of casing:	pue	
Screen length: <u>40</u> feet Screen diamete	ar: 16	inches Type of screen:		
_			/	
	-	feet to/	20 feet	
Type of completion (circle all applicable): Gravel p	acked Under	reamed Telescoped Open	hole Natural Development	
Other (c	lescribe):		······································	
Top of lap pipe or reduction in casing:	feet. If te	lescoped or more than one scr	een, describe on back of page	
Logs run (circle all applicable): No log run Electric	c Gamma Ray	Density Sonic Neutron	Other:	
Name of organization running log(s):				
I certify that the well was drilled, constructed, and	-			
Department of Environmental Quality and/or the l	Mississippi Dep	artment of Health regulations	and state laws.	
Charles M. Nichols o	-067	Charles	M. Jucholo	
Print Name of Water Well Contractor and License No).	Signature of	f Water Well Contractor	
		······································	RECEVED	
			N 14 B 6 2005	

- 1. 18


BY: OLWR

If well telescopes please sketch below and show depths.

Ground Level

and show depths.	B-81						
	Description of Formations Encountered	From	То				
	Chuy	0	37				
	med sand	37	50				
	Course Sand	50	60				
	med + course sand	60	80				
	Couse sand + p-gravel	80	120				
	. / J						
			ļ				
			+				
		_					
			1				
			+				
			+				
		_	+				
			1				
			1				

If more than one screen, show location of each on sketch

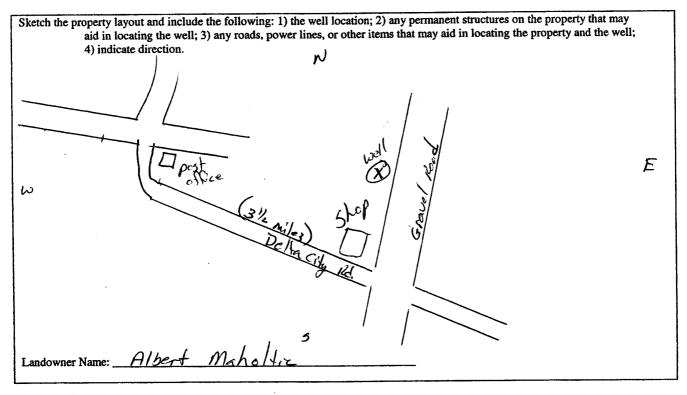

Signature of Water Well Contractor

RECEIVED

· _						
•	STATE WE	LL REPOR	Т			
		art 2				
communication Short River	Pump Installer's Completion Report			For O	fice Use Only:	
County: <u>Sharkey</u> Permit #:	Mississippi Department of Environmental Quality			Aquifer:		
Permit #:	Office of Land and Water Resources					
Driller: Charlos M. Aichols		P.O. Box 10631 Jackson, MS 39289-0631		Well #: _B	-71	
	-	961-5210				
Date completed: $5 - 28 - 05$	(601)354-6938 (fax)			Elevation:		
This report should be prepared by t	ı 1e pump installer in detai	l and filed with the	Department v	vithin 30 da	ys of the	
installation of pump.	48	<u>г</u>	Well L	ocation		
Well Owner Informa	,			Junion	Ø ;	
Dwner Name: Albert Mah	alite	Latitude: 33	<u>03 28 N</u> L	ongitude: <u></u>	090 45 08 L	
	+ (1)000	Method of Lat/Long (circle one): Conventional Survey,				
Mailing Address: 6500 Hwy 1	+ West	Method of Lat/Loi	ng (circle one):	Conventio	nai Suivey,	
		USGS	quad, Hand-he	eld GPS, Su	irvey-grade GPS	
DI . Eni	15 39159	المراجع المراجع	1.0.	Trem - 1/4	A Pro Elis	
VSOIING FORK	<u>Zip Code</u>	IVE 1/4			N Rng 5W	
City State	Lip Code		Direction	Nearest T	'own	
		Distance			C. A.	
Telephone No. ()		<u> 31/2</u> Miles _	<u>5</u> of _	Delta	city	
		<u> </u>				
Pump Type	<u></u>			r Type	· · · · · · · · · · · · · · · · · · ·	
Circle one			Circ	le one		
Air Lift Jet	Submersible	DieselEngine	Gasoline	Engine	Natural Gas	
Bucket Piston	Turbine	Electric Motor	Hand		Tractor PTO	
Centrifugal Rotary	Flowing Well	Windmill	Other (sp	ecify):	copane_	
- /	<u> </u>			,	•	
Other (specify): <u>Customer</u>	unp.)	Horse Power Rati	ing of Motor: _			
Date Pump Installed: 5-28-0	5-	Setting Depth:	60		feet	
			,			
Rated Pump Capacity: 3000	Gallons Per Minute	Number of Stages	s:			
Pump Test Data		м	ethod of Meas	uring Wate	er Level	
rump rest Dat	•			le one		
Date Well Tested:			Manual of March	uiu a T in a	Steel Tone	
Or de Michael 1 (A).	at Dalow I and Curface	Air Line	Electric Measu	ring Line	Steel Tape	
Static Water Level (A):Fe	er delow Land Sufface	Other (specify):				
Pumping Water Level (B):Fee	et Below Land Surface					
Drawdown [(B) – (A)]:Fe		For flowing well	, measured shu	t in head:	feet	
		Well yielded		GPM with	a drawdown of	
Test Pumping Rate:	Gallons ref Minute					
Duration of Pump Test (minimum 4 hour	s):hours		feet after		_hours of pumping	
		- 1				
I HEREBY CERTIFY that the above stat	1	of my knowledge.	\land			
Charles M. Aichol-	5 0.0667	_ Cha	re of Pump Ins	n.M.	how	
Print Name of Pump Installer and Licens	e No. (if applicable)	Signatu	re of Pump Ins	taller	·	
	2 numers.	punp.				
Lan	L'owners.	punp.				

NUM 0 6 2005 BY: OLWR