
01 1	STATE WELL REPORT	
county: Sharkey	Part 1	For Office Use Only:
Permit #: GW- 46375	Driller's Log	Well #: 3134
Driller: Clarence MC Mussy	Mississippi Department of Environmental Quality Office of Land and Water Resources	Aquifer:
Date drilling completed: <u>11-1-12</u>	P.O. Box 2309 Jackson, MS 39225-2309	E-Log #:
·····	(601)961-5210	L
	(601)360-0535 (fax)	

۰. ۱

State Law requires that this report be prepared by the license holder responsible for the work and filed with the Department at the above address within 30 days of completion of drilling of the well or borehole.

#1700 Well Owner Information Site 5					
(Landowner if borehole is not for a water well)	Well or Borehole Location				
Owner Name: JWB MS LLC	Latitude: <u>33° 04′ 03″</u> Longitude: <u>90° 40′ 47"</u>				
Mailing Address: 4424 Czrolinz Hwy	Method of Lat/Long (check one): Conventional Survey,				
	USGS quad, Hand-held GPS, Survey-grade GPS				
Denmark Sc 29042 City State Zip Code	<u>SW 1/4 SE 1/4, Sec_11_T/YN ROJW</u>				
	10 Miles West of Silver City				
Telephone No. (<u>662) 347 - 809 0</u>	(Distance) (Direction) (Nearest Town)				
	orehole Data				
Date drilling started: <u>1-1-12</u> Date drilling completed:	11-1-12 Hole depth: 135 Hole diameter: 26"				
Location of the source of any surface water used for drilling: Ditch 1/2 miles Away					
Method of dosing and volume of Chlorine used in drilling and development:					
Logs run (circle all applicable): No log run Electric Gamma Ray Density Sonic Neutron Other:					
Name of organization running log(s):					
Purpose of borehole (circle one): Water Well Geotechnical/Geological Investigation Ground Source Heat Pump					
Seismic Survey Other (describe)				
If drilling is not related to water well construction, skip the remainder of this block					
Purpose of Well (circle all applicable): Home Industrial Public Supply Irrigation Fish Culture					
Other (describe):					
If a flowing well, method of flow regulation: Valve Other (describe)					
Static Water Level: 20 feet [above or below] land surface Date measured: $3-9-13$ (circle one)					
Method of measurement (circle one): Steel tape Electric tape Air line Other (describe):					
Well depth: 135^{-1} Well grouted to a depth of: 10^{-1} feet Type of grout (<i>circle one</i>): Neat Cement Bentonite Mix					
Casing length:					
Screen length: <u>LeO</u> feet Screen diameter: <u>16</u> inches Type of screen: <u>PUC</u>					
Screen slot size:					
Type of completion (circle all applicable): Gravel packed Underreamed Open hole Natural Development (CT)					
Other (describe):	RECEIVED				
Top of lap pipe or reduction in casing: \cancel{A}	UN 1 9 2013				
If telescoped or more than o	one screen, describe on next page				
	Forn OWR SUR MAY 4/1				

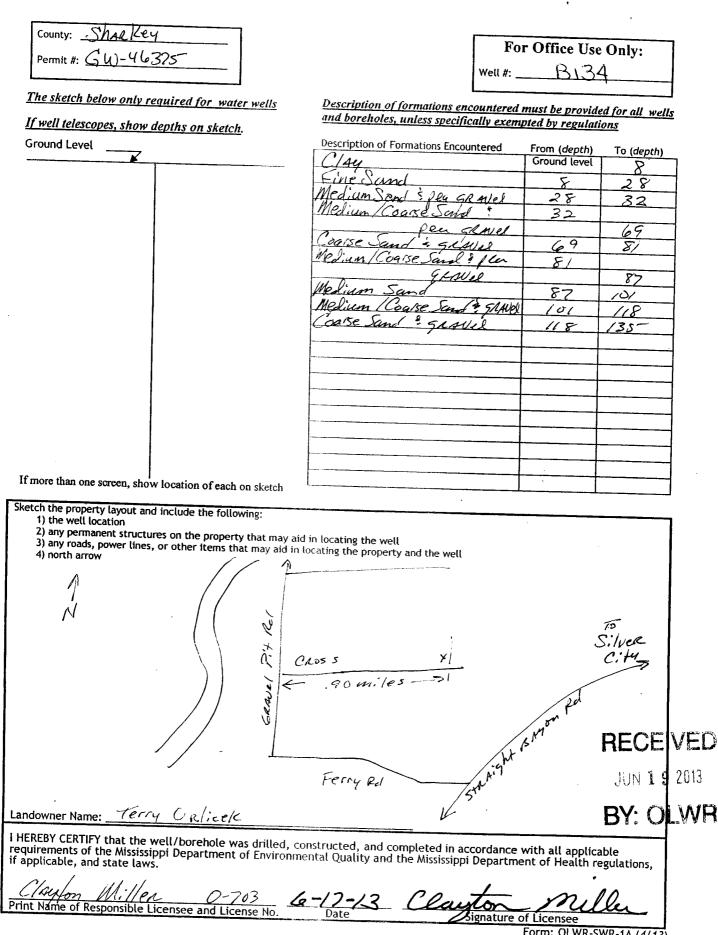

Form: OLWR-SWR-1A (4/13)

	STATE WELL REPORT	
Shockey	Part 2	For (
5W-46375-	Pump Installer's Completion Report	FOL
hn Rybolt I	Mississippi Department of Environmental Quality	Well #:
nn Kybolt K	Office of Land and Water Resources	

County: _

Permit #: G W Driller: John

Date completed:

Copy information from block on Part

13

P.O. Box 2309 Jackson, MS 39225-2309 (601)961-5210 (601) 360-0535 (fax)

For Office Use Only:		
Well #: <u></u>		
Aquifer:		

This part of the report must be completed by a licensed water well contractor or a licensed pump installer. A copy of Part 1 of the report must be attached and both parts filed with the Department at the above address within 30 days of well completion. Well Owner Information · Well Location Latitude: 1/33° 04 ' 03'' Longitude: 1070° 40' 47" UL JW 3 MS Owner Name:

Mailing Address: <u>4424 Canolina / twy</u> Den Mank <u>5C</u> 29042 City State Zip Code	Method of Lat/Long (<i>check one</i>): Conventional Survey, USGS quad, Hand-held GPS, Survey-grade GPS 				
Telephone No. (662) 347-8090	$\frac{(O)}{(Distance)} \text{ Miles } \underbrace{\text{West}}_{(Direction)} \text{ of } \underbrace{\text{Silver (i+4)}}_{(Nearest Town)}$				
Pump Typ	e (circle one)				
Submersible Turbine Air Lift Centrifugal Flowing Well Jet Piston Rotary Other (describe):					
Date Pump Installed: <u>3-9-13</u> Rated Pump Capacity:Gallons Per Minute					
Is This Pump (circle one): New Repaired Replacement					
	pe (circle one)				
Electric Diesel Gasoline Natural Gas Tractor PTO Windmill Other (describe):					
Horse Power Rating of Motor:					
Pump Test Data for Non Flowing Well					
Date Well Tested: NOT TESTED Duration of Pump Test (minimum 4 hours): N/A hours					
Static Water Level (A): Feet Below Land Surface Pumping Water Level (B): Feet Below Land Surface					
Drawdown [(B) - (A)]:Feet Below Land Surface Test Pumping Rate:/A Gallons Per Minute					
Method of measurement (circle one): Steel tape Electric ta					
	a for Flowing Well N/A				
Measured shut in head:feet.	,				
Well yieldedGPM with a drawdown of	feet_afterhours of pumping				
Meter I	Meter Installation				
Meter Manufacturer: MCC Nometer	Meter Serial Number: 12-05262				
Meter Model Number/Name: MO310 Type of Meter: Propelle Suddle					
Totalizer Register Unit and Multiplier Factor (AF x .001, gal x 1000, etc): <u>GAL x GAL</u>					
Totalizer Register Unit and Multiplier Factor (AF x .001, gal x 1000, etc): <u><u>GAC x GAC</u> Installation Date: <u>5-24-13</u> Meter installed by: <u>Mid South Wath in Works (CC</u></u>					
Is This Meter (circle one): New Repaired Replacement					
Important: By submitting the above information you are certifying that this meter was installed to manufacturer standards. For agricultural wells, a list of approved meters is on the MDEQ website.					
I HEREBY CERTIFY that the above statements are true to the best of my knowledge.					
Print Name of Pump Installer and License No. (if applicable) Date Signature of Pump Installer					

BY: OLWP

Form: OLWR-SWR 18 (4013)013

ED