

Sharkey
B 2000
12/8/77

MISSISSIPPI
BOARD OF WATER COMMISSIONERS
416 North State Street
Jackson, Mississippi 39201

WATER WELL DRILLERS LOG
BUTANE GAS COMPANY

SHarkey
county well located

12-8-77 19
date well completed


OF GREENWOOD

LANDOWNER:	description of formations encountered	from	to
MRS. Nathilee King AN Guilla (mailing address)			
WELL LOCATION:	Clay	0	18
sec. 23 T. 4 N R. 5 E	Sand	18	50
7 miles NW of Midnight	Sand & Gravel	50	122
(distance) (direction) (nearest town)	Gravel	122	145
WELL PURPOSE: Home	Sand	145	250
(home, irrigation, municipal, industrial)	Clay	250	312
WELL COMPLETION DATA:	Sandy shale	312	320
(1) diameter (inches) 4 1/2	Shale & Rock	320	370
(2) total depth (feet) 630	Shale	370	402
(3) static water level (feet) 18 below top of ground.	Sand & shale	402	487
(4) casing Steel, 6 1/2 (material) (depth)	Fine sand	487	595
4 1/2 (size) if telescope see back.	Hard packed sand	595	635
(5) screen 20, 6 1/2 (length) (depth to top)	Sand & shale	635	640
2" Stainless (size) (material)			
(6) pump 1, 20 (HP) (yield gpm)			
Elec (type power)			
(7) electric log No (yes or no)			
(organization running log)			
(8) how well bottom plugged Back pressure valve			
DRILLERS REMARKS:			

RECEIVED
DEC 19 1977
MISS. BD. OF WATER COMM.

If well telescopes please sketch and show depths.

GROUND LEVEL

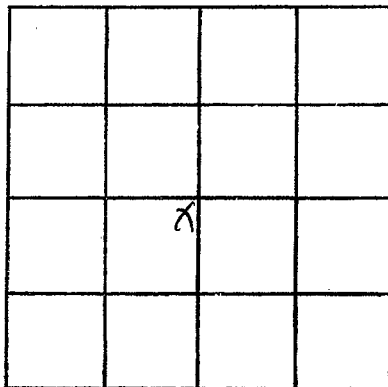

SECTION 23

Please indicate well location X.

ADDITIONAL INFORMATION

If more than one screen, show locations of each on sketch.