

SHARKEY

B

2002

MISSISSIPPI BOARD OF WATER COMMISSIONERS  
416 North State Street  
Jackson, Mississippi 39201

WATER WELL DRILLERS LOG

5-16

19

78 OWENS PLYG CO.

Sharkey

date well completed

firm name

county well located

LANDOWNER: Alice Cody W.

Jackson

Rt. Box 197 Anguilla MS  
38707 (mailing/address)

WELL LOCATION:

sec. 34 T 14 N R 5 E  
12 miles east of Anguilla  
(distance) (direction) (nearest town)

WELL PURPOSE:

(home, irrigation, municipal, industrial)

WELL COMPLETION DATA:

- (1) diameter (inches) 2"
- (2) total depth (feet) 490'
- (3) static water level (feet) 18' below top of ground.
- (4) casing 2" 480' (material) (depth)
- (size) if telescope see back.
- (5) screen 10' 490' (length) (depth to top)
- 2" PVC (size) (material)
- (6) pump 1/2 HP 12 (yield gpm)
- Electric (type power)
- (7) electric log NO (yes or no)
- (organization running log)
- (8) how well bottom plugged S/B

description of formations encountered

from

to

top soil

0 43'

clay

43 260

sand & gravel

260 300

sand

300 490'

RECEIVED

MAY 30 1978


DRILLERS REMARKS:

Owens

MISS. BOARD OF WATER COMM.

If well telescopes please sketch and show depths.

GROUND LEVEL

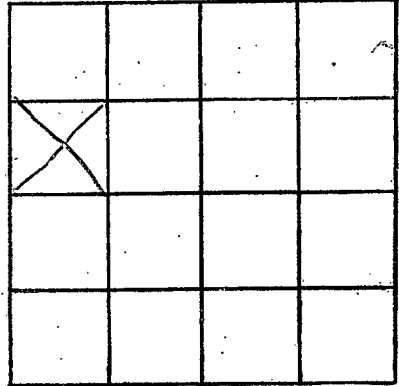

SECTION 24

Please indicate well location X.

ADDITIONAL INFORMATION

If more than one screen, show locations of each on sketch.