

MISSISSIPPI DEPARTMENT OF ENVIRONMENTAL QUALITY
Bureau of Land and Water Resources

P. O. Box 10631
Jackson, MS 39289-0631
WATER WELL DRILLERS LOG

COUNTY WELL LOCATED	
Sharkey	
WELL NUMBER	CODED
Well-1	
DATE WELL COMPLETED	
4/11/94	

PERMIT NUMBER
NAME OF DRILLING FIRM
Layne-Central

NAME & MAILING ADDRESS OF LANDOWNER		
Craig Boykin		
P.O. Box 524		
Hollandale, MS 38748		
WELL LOCATION:	SEC	TOWNSHIP RANGE
	9	T14 ^N R6 ^W S15 ^E
DISTANCE	DIRECTION	NEAREST TOWN
1 1/2 Miles	East	of Delta City
OTHER LANDMARK		
WELL PURPOSE: Home Irrigation Municipal, Industrial, Fish Pond, etc.		

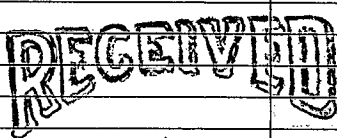
PUMP DATA		
PUMP TYPE (Circle One): Submersible, <u>Turbine</u> , Jet Flowing Well, Other (Describe)		
POWER TYPE (Circle One): Electric, Tractor, <u>Diesel</u> , Gasoline, Butane, Other (Describe) H/P <u>60</u>		
Pump Capacity (GPM)	No. of Stages	Setting Depth
2500	1	60' FT.
PUMP TEST		
NOT TESTED		
Well yielded _____ GPM with a drawdown of _____ ft. after _____ hours of pumping		

WELL DATA		
Well Depth	Casing Diameter (In.)	Casing Length (Ft.)
124'	16"	74'
Type of Casing	Hole Depth	Depth to Static Water Level
PVC	124'	20'
TYPE OF COMPLETION: (Circle One or More): <u>Gravel Packed</u> , Underreamed, Telescoped, Natural Development, Open Hole, Other (Describe)		
Top of Lap Pipe or Reduction in Casing		
N/A FEET IF TELESCOPED OR MORE THAN ONE SCREEN: USE BACK PAGE		

LOG DATA	
TYPE OF LOG RUN (Circle One): Electric, Gamma Ray, Density, Sonic, Neutron, Other (Describe) No Log Run	
Name of Organization Running Log	

SCREEN DATA		
Diameter - Inches	Length - Feet	Slot Size - Inches
16"	50'	.060"
Screen Type	Depth to Bottom - Feet	
PVC	124'	

GEOLOGIC DATA (Office Use Only)			
Surface Elev.	Geologic Unit	Unit Thickness	Depth to Top
Subs. SWL	Date	Analysis	Aquifer Test
Driller's Remarks			

DESCRIPTION OF FORMATIONS ENCOUNTERED	FROM	TO	FORMATIONS (Continued)	FROM	TO
Clay	0	18	 JUL 22 1994 Dept. of Environmental Quality Office of Land & Water Resources		
Sand Brown	18	40			
Coarse & Pee Gravel	40	70			
Pee Gravel	70	124			

IF MORE SPACE IS NEEDED, USE BACK

