

MISSISSIPPI DEPARTMENT OF NATURAL RESOURCES

Bureau of Land and Water Resources

Southport Mall

P.O. Box 10631

Jackson, Mississippi 39209

WATER WELL DRILLERS LOG

CODED

SHARKEY  
C  
11-1-83  
Elog # 111

Nov. 1 1983 L.M. Bud Cresswell Sharkey  
date well completed firm name county well located

LANDOWNER:  
Green Baggett  
Rolling Fork, MS.  
(mailing address)

description of formations encountered	from	to
Clay	0	20
Sand - gravel	20	185
Shale	185	240
Sand	240	300
Shale	300	340
Sand	340	490
Shale	490	740
Sandy - thin shale	740	775
sandy shale	775	920

WELL LOCATION:  
sec 26 T 13 N R 6 E  
5 miles EAST of Rolling Fork  
(distance) (direction) (nearest town)

WELL PURPOSE: Home  
(home, irrigation, municipal, industrial)

WELL COMPLETION DATA:

(1) diameter (inches) 4

(2) total depth (feet) 920

(3) static water level (feet) 30 below top of ground

(4) casing Steel 740  
(material) (depth)  
4 (size) if telescope see back.

(5) screen 55 740  
(length) (depth to top)  
2 Stainless  
(size) (material)

(6) pump 5 60  
(HP) (yield gpm)  
0 (type power)

(7) electric log Yes  
(yes or no)  
State  
(organization running log)

(8) How well bottom plugged  
Back wash

CODED

11-1-83

DEPT. OF NATURAL RESOURCES  
BUREAU OF LAND & WATER RESOURCES


NOV 23 1983

RECEIVED

DRILLERS REMARKS:

If well telescopes please sketch and show depths.

GROUND LEVEL

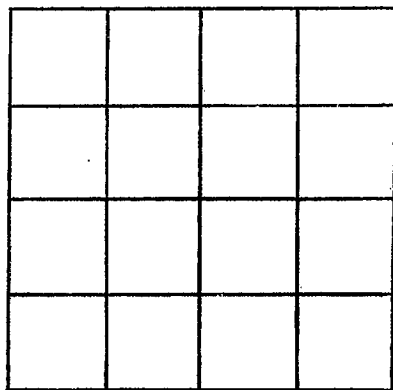

SECTION \_\_\_\_\_

Please indicate well location X.

ADDITIONAL INFORMATION

If more than one screen, show locations of each on sketch.