

MISSISSIPPI
 BOARD OF WATER COMMISSIONERS
 416 North State Street
 Jackson, Mississippi 39201

CODED

WATER WELL DRILLERS LOG

SHARKEY
C 8
11-10-71

11/10/71 1971 DYER WELL TRR. SHARKEY
 date well completed firm name county well located

LANDOWNER:

JOE STEVENS

ANGHILLA, MISS.
 (mailing address)

WELL LOCATION:

sec. 14 T 13 N R 6 E
 2 1/2 miles EAST of ANGHILLA
 (distance) (direction) (nearest town)

WELL PURPOSE:

HOME (home, irrigation, municipal, industrial)

WELL COMPLETION DATA:

- (1) diameter (inches) 4" x 2"
- (2) total depth (feet) 772'
- (3) static water level (feet) 28' below top of ground
- (4) casing 4" PVC (material), 75.2' (depth)

_____ If telescope see back.
 (size)

- (5) screen 20' (length), 75.2' (depth to top)
 2" STAINLESS STEEL (size) (material)

- (6) pump 1 (HP), 28 GPM (yield gpm)

ELEC (type power)

- (7) electric log N/O (yes or no)

_____ (organization running log)

- (8) how well bottom plugged B.P.U.

DRILLERS REMARKS:

description of formations encountered	from	to
CLAY	0	30
SAND	30	65
SAND + GRAVEL	65	130
ROCK	130	137
CLAY	137	142
SAND	142	212
SAND	212	318
SANDY CLAY	318	410
SHALE	410	590
ROCK	590	591
SANDY SHALE	591	697
SAND	697	772


CODED

NOV 12 1971

MISS. BD. OF
 WATER COM.

If well telescopes please sketch and show depths.

GROUND LEVEL

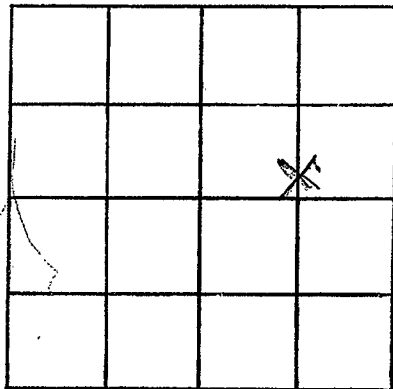

SECTION 14

Please indicate well location X.

ADDITIONAL INFORMATION

If more than one screen,
show locations of each on sketch.