

EC 15
9-12-60

WATER WELL DRILLERS LOG

CODED

Date: SEPT. 12, 1960, Driller: DELTA DRILLING Co. County: DELAWARE
(Name)

(1) Owner of Land: I. G. ALEXANDER
(Name)
ROLLING FORK, MISS
(Address)

(2) Location: 1/4, 1/4, Sec. 35 T3R7
_____ miles _____ of _____
(distance) (direction) (Nearest Town)

(3) Topography: _____
(Hilly) (Flat) (Level)

(4) Purpose of Well: DOMESTIC
(Domestic Irrigation
Municipal, Industrial, Other)

Description & Color of Materials Sand, Clay, Red Clay, Shell, etc.	Thick- ness Feet	Depth Feet
SAND & GRAVEL	139	139
GUMBO	61	200
SANDY SHALE w/10" ROCK ^{295'}	243	443
SAND	87	530
SHALE w/10" ROCK @ 565'	88	618
SAND & SHALE w/8" ROCK @ 635'	93	711
SHALE w/11" ROCK @ 725'	89	800
SAND w/8"	57	857
SANDY SHALE w/15" ROCK ^{980'}	145	1002
SAND	63	1065
SANDY SHALE	14' 10"	1079' 10"

Information upon completion of well:

(1) Diameter 3 inches.

(2) Total Depth 1079 feet. 10"


(3) Water Level 10 feet below top of ground.

(4) Cased to 1079' 10", Size 3" 104' 6"
2" 955' 4"

(5) Screen: Size 2, Length 20

(6) Were any formations sealed against pollution?
_____ yes, _____ no.

CODED

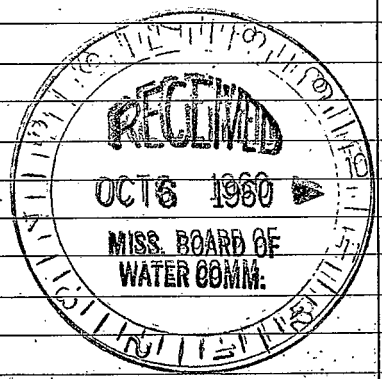

If YES depth of formation _____

Why _____

Drillers Remarks: _____

(Use Back Side)

Well No.

