

54 Harley
C17
2-66
Date: 2/10

WATER WELL DRILLERS LOG

CODED

Date: 2/10, 19 66, Driller: Butane Gas Co. of Green County, (Name)

(1) Owner of Land: Raymond Brown
(Name)
Anguilla, Miss.
(Address)

(2) Location: 1/4, 1/4, Sec. 27 T13R6,
5 miles S. W., of Anguilla
(distance) (direction) (Nearest Town)

(3) Topography: flat
(Hilly) (Flat) (Level)

(4) Purpose of Well: irrigation
(Domestic Irrigation
Municipal, Industrial, Other)

Description & Color of Materials. Sand, Clay, Red Clay, Shell, etc.	Thick- ness Feet	Depth Feet
Top soil & clay	0	13
Brown clay	10	23
" "	10	33
Coarse sand	10	43
Sand & gravel	10	53
" " "	10	63
" " "	10	73
" " "	10	83
" " "	10	93
" " "	10	103
" " "	10	113

Information upon completion of well:

(1) Diameter 16 inches.

(2) Total Depth 103 feet.


(3) Water Level 16 feet below top of ground.

(4) Cased to 63', Size 16

(5) Screen: Size 16, Length 40'

(6) Were any formations sealed against pollution?
X yes, no.

CODED

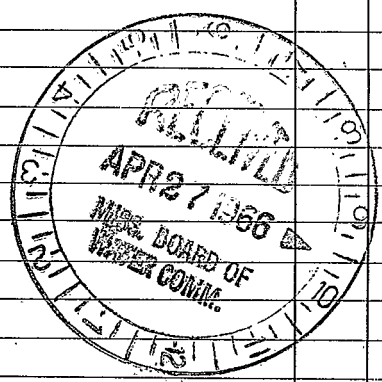

If YES depth of formation _____

Why _____

Drillers Remarks: _____

Retain this copy for your office files.

(Use Back Side)

Well No.

