

Sharkey
~~657099~~
 4-67

MISSISSIPPI CODED
 BOARD OF WATER COMMISSIONERS
 416 North State Street
 Jackson, Mississippi 39201

5/17/67
 Jan
 2420

WATER WELL DRILLERS LOG

April 18, 1967 Layne-Central Company Sharkey
 date well completed firm name county well located

LANDOWNER: Sunflower Catfish Farm, Inc.

description of formations encountered	from	to
Clay	0	22
Fine sand	22	31
Fine sand, clay balls	31	48
Coarse sand, pea gravel	48	97
Coarse sand, gravel	97	111
Hard pink clay	111	112

Anguilla, Mississippi
 (mailing address)


WELL LOCATION: NE SE
 sec 27 T 13 R 6 E
 S
 4 miles SE of Anguilla
 (distance) (direction) (nearest town)

CODED

WELL PURPOSE: irrigation
 (home, irrigation, municipal, industrial)

WELL COMPLETION DATA:

- (1) diameter (inches) 16
- (2) total depth (feet) 112
- (3) static water level (feet) 19' 6" ~~above~~ above top of ground.
- (4) casing steel, 62' (material), (depth),
 16" (size) if telescope see back.
- (5) screen 50' (length), ~~37'~~ 62' (depth to top)
 16" (size), Armeo (material)
- (6) pump 60 (HP), ~~2100~~ 3300 (yield gpm)
 electric (type power)
- (7) electric log no (yes or no)
 (organization running log)
- (8) how well bottom plugged plate

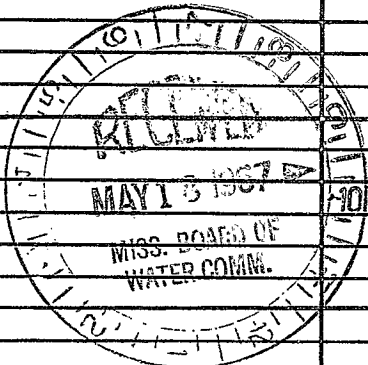

DRILLERS REMARKS:

If well telescopes please sketch and show depths.

GROUND LEVEL

SECTION _____

Please indicate well location X.

ADDITIONAL INFORMATION

If more than one screen, show locations of each on sketch.