

WATER WELL DRILLERS LOG

OK 7/29/69

Date: 2, 1965, Driller: DAVID BERRY County: Sharkey

(Name)


(1) Owner of Land: H. H. Carpenter
 (Name)
Rolling Ford, Miss.
 (Address)
35 13-7
 (2) Location: 1/4, 1/4, Sec. T R
_____ miles _____ of _____
 (distance) (direction) (Nearest Town)
 (3) Topography: Flat
 (Hilly) (Flat) (Level)
 (4) Purpose of Well: Domestic
 (Domestic Irrigation
 Municipal, Industrial, Other)

Description & Color of Materials Sand, Clay, Red Clay, Shell, etc.	Thick- ness Feet	Depth Feet
<u>Kelly</u>	<u>35</u>	
<u>Overlybedded sand</u>	<u>31</u>	<u>66</u>
<u>sand & gravel</u>	<u>31</u>	<u>97</u>
<u>gravel</u>	<u>31</u>	<u>128</u>
<u>Shale</u>	<u>31</u>	<u>159</u>
<u>Shale & lignite</u>	<u>31</u>	<u>190</u>
<u>Shale</u>	<u>31</u>	<u>221</u>
<u>Shale & sand</u>	<u>31</u>	<u>252</u>
<u>Shale & sand</u>	<u>31</u>	<u>283</u>
<u>Shale & rock</u>	<u>31</u>	<u>314</u>
<u>hard packed sand</u>	<u>31</u>	<u>345</u>
<u>sand cut good</u>	<u>31</u>	<u>376</u>
<u>sand with shell</u>	<u>31</u>	<u>407</u>
<u>sand</u>	<u>31</u>	<u>438</u>
<u>good drop sand</u>	<u>31</u>	<u>469</u>
<u>Shale</u>	<u>31</u>	<u>500</u>
<u>Shale & sand</u>	<u>31</u>	<u>531</u>
<u>sand & 12 necks</u>	<u>31</u>	<u>562</u>
<u>sand not good</u>	<u>25</u>	<u>587</u>
<u>sand & sandy shale</u>	<u>21</u>	<u>608</u>
<u>sand cut good</u>	<u>21</u>	<u>629</u>
<u>shale & shale break</u>	<u>21</u>	<u>650</u>
<u>sand & shell</u>	<u>21</u>	<u>671</u>
<u>11 1/2</u>	<u>21</u>	<u>692</u>
<u>11 1/2</u>	<u>21</u>	<u>713</u>
<u>Shale</u>	<u>21</u>	<u>734</u>
<u>Shale</u>	<u>21</u>	<u>755</u>
<u>Shale</u>	<u>21</u>	<u>776</u>
<u>sand & shale</u>	<u>63</u>	<u>839</u>
<u>Shale</u>	<u>42</u>	<u>881</u>
<u>sand</u>	<u>44</u>	<u>925</u>

Information upon completion of well:

(1) Diameter 4 3/8 x 2 inches.
 (2) Total Depth 96.5 feet.
 (3) Water Level 10 feet below top of ground.
 (4) Cased to 9.25, Size 4", 3", 2"
 (5) Screen: Size 1008, Length 40
 (6) Were any formations sealed against pollution?
 _____ yes, _____ no.

If YES depth of formation: _____
 Why: _____
 Drillers Remarks: _____

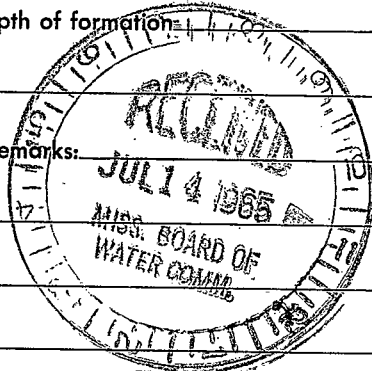

(Use Back Side)

Well No.

