

CODED

CODED

Sharkey
C 47
12-22-69

MISSISSIPPI
BOARD OF WATER COMMISSIONERS
416 North State Street
Jackson, Mississippi 39201

WATER WELL DRILLERS LOG

DYER WELL & IRRIGATION SERVICE

SHARKEY

12/22/69 19
date well completed

firm name

county well located

LANDOWNER:

Raymond Brown

description of formations
encountered

from

to

ANGUILLA, Miss.
(mailing address)

CLAY	0	23
FINE SAND	23	33
COARSE SAND & GRAVEL	33	106

WELL LOCATION:

sec. 28 T 13 N R 6 E
S W
3 miles S of ANGUILLA
(distance) (direction) (nearest town)

WELL PURPOSE:

Ind.

(home, irrigation, municipal, industrial)

WELL COMPLETION DATA:

- (1) diameter (inches) 16
- (2) total depth (feet) 106
- (3) static water level (feet) 16 below
top of ground.
- (4) casing Steel 66'
(material) (depth)
16" if telescope see back.
(size)
- (5) screen 40 66'
(length) (depth to top)
16" Steel
(size) (material)
- (6) pump 60 3000
(HP) (yield gpm)
Elec.
(type power)
- (7) electric log No
(yes or no)

(organization running log)

(8) how well bottom plugged Plate


JAN 26 1970

MISSISSIPPI
BOARD OF WATER COMMISSIONERS
RECORDS SECTION

DRILLERS REMARKS:

If well telescopes please sketch and show depths.

GROUND LEVEL

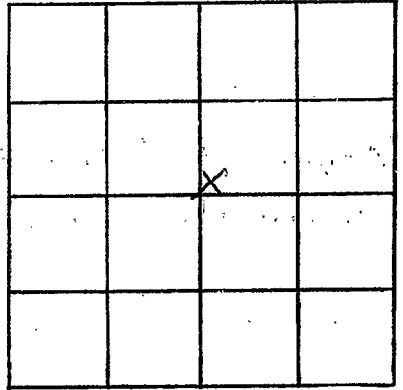

SECTION 28

Please indicate well location X.

ADDITIONAL INFORMATION

If more than one screen,
show locations of each on sketch.