

CODED  
CODED

MISSISSIPPI  
BOARD OF WATER COMMISSIONERS  
416 North State Street  
Jackson, Mississippi 39201

Sharkey  
C 48  
12-22-69

WATER WELL DRILLERS LOG

DYER WELL & IRRIGATION SERVICE

SHARKEY

12/22/69 19  
date well completed

firm name

county well located


LANDOWNER:	description of formations encountered	from	to
Raymond Brown	Clay	0	33
ANGUILLA, MISS. (mailing address)	Fine Sand	33	48
	COARSE SAND	48	53
WELL LOCATION:	SAND + GRAVEL	53	63
sec. 28 T. 13 N R. 6 E 5 S W	COARSE SAND	63	93
3 miles S of Anguilla (distance) (direction) (nearest town)	SAND + PEA GRAVEL	93	103
WELL PURPOSE: Ind. (home, irrigation, municipal, industrial)	COARSE SAND	103	113
WELL COMPLETION DATA:			
(1) diameter (inches) 16			
(2) total depth (feet) 113			
(3) static water level (feet) 18 below top of ground.			
(4) casing Steel, 73 (material), (depth), 16" (size) if telescope see back.			
(5) screen 40, 73 (length), (depth to top) 16" (size), Steel (material)			
(6) pump 60 (HP), 3000 (yield gpm) Elec. (type power)			
(7) electric log No (yes or no)			
(organization running log)			
(8) how well bottom plugged Plate			
DRILLERS REMARKS:			

JAN 26 1970

MISS. DEPT. OF  
WATER CONTROL

If well telescopes please sketch and show depths.

GROUND LEVEL

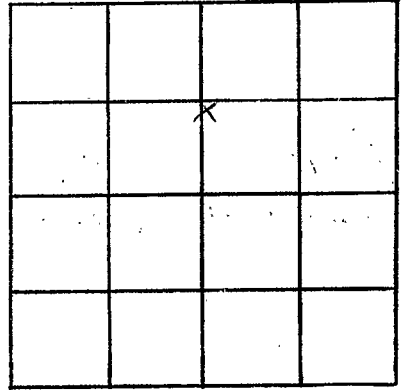

SECTION 28

Please indicate well location X.

ADDITIONAL INFORMATION

If more than one screen,  
show locations of each on sketch.