

Sharkey  
C49

6-66 MISSISSIPPI BOARD OF WATER COMMISSIONERS

9/26/66  
m

WATER WELL DRILLERS LOG

**CODED**

Date: June 20, 19 66, Driller: Layne-Central Company County Sharkey  
 (When well drilled) (Name) (Where well is located)

(1) Owner of Land: Sharkey Country Club  
 (Name)  
Anguilla, Mississippi  
 (Address)

(2) Location: 1/4, 1/4, Sec. 14 T3R6,  
3 miles east of Anguilla,  
 (distance) (direction) (Nearest Town)

(3) Topography: flat  
 (Hilly) (Flat) (Level)

(4) Purpose of Well: domestic  
 (Domestic Irrigation  
 Municipal, Industrial, Other)

Description & Color of Materials Sand, Clay, Red Clay, Shell, etc.	Thick- ness Feet	Depth Feet
Clay	31	31
Soft blue clay	11	42
Coarse sand	28	70
Coarse sand & pea gravel	110	180
Coarse sand	99	279
Coarse sand & hard strks.	9	288
Clay with hard strks.	20	308
Sand and small clay strks.	72	380
Clay with sandy strks.	95	475
Clay & sand strks.	15	490
Hard clay	48	538
Sand rock	1	539
Hard clay	21	560
Sand clay with hard strks.	42	602
Hard clay	35	637
Hard shale with sandy strks.	33	670
Hard shale	40	710
Clay with sandy strks.	65	775
Hard white clay	51	826
Hard rock	1	827
Hard clay	16	843
Sandy clay	23	866
Hard clay	72	938
Sandy clay	16	954
Sand	20	974
Clay	25	989
Sand	93	1082

Information upon completion of well:

(1) Diameter 8x4 inches.

(2) Total Depth 1082 feet.

(3) Water Level 6' 8" feet below top of ground.  
861' 10" 4"

(4) Cased to 192', Size 8"  
1' 2" of 8x4 swage

(5) Screen: Size 4", Length 51'  
8' of 4" Blank

(6) Were any formations sealed against pollution?  
yes yes, no no.

If YES depth of formation. Cemented casing,  
lead seal and shot at bottom.


Why \_\_\_\_\_

Drillers Remarks: \_\_\_\_\_

Yield in gpm: \_\_\_\_\_

Size pump: \_\_\_\_\_

Type power: \_\_\_\_\_

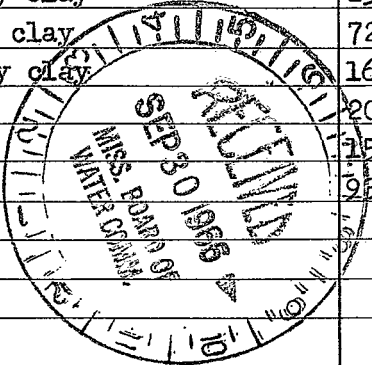

Mail this copy to Board of Water Commissioners 429 Miss. St. Jackson, Miss.

