

SHARKEY
C 52

11-27-72

MISSISSIPPI
BOARD OF WATER COMMISSIONERS
416 North State Street
Jackson, Mississippi 39201

CODED

WATER WELL DRILLERS LOG

11-27 1972 date well completed
Bailey Drilling Co. firm name
Sharkey county well located

LANDOWNER: Josie Nelson
Anquilla
Miss.
(mailing address)

description of formations encountered	from	to
Clay Sands	0	30
	30	68

WELL LOCATION:
sec. 13 T. 13 N R. 6 E
4 miles E of Anquilla
(distance) (direction) (nearest town)

WELL PURPOSE: Home
(home, irrigation, municipal, industrial)

- WELL COMPLETION DATA:
- (1) diameter (inches) 2"
 - (2) total depth (feet) 68
 - (3) static water level (feet) 15 below top of ground.
 - (4) casing steel, 63 (material) (depth)
2" (size) if telescope see back.
 - (5) screen 5' 63 (length) (depth to top)
2" Brass (size) (material)
 - (6) pump 1/2 6 (HP) (yield gpm)
Elec (type power)
 - (7) electric log no (yes or no)

CODED

DEC 1 1972


(8) how well bottom plugged
Back pressure valve

MISS. BD. OF
WATER COMMISSIONERS

REMARKS:

If well telescopes please
sketch and show depths.

GROUND LEVEL

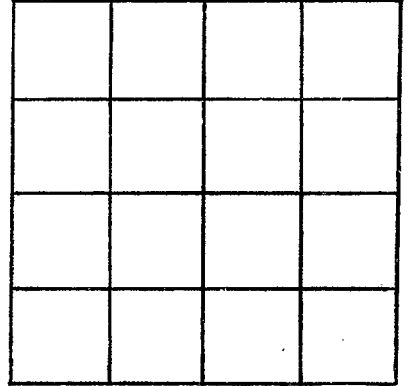

SECTION _____

Please indicate well location X.

ADDITIONAL INFORMATION

If more than one screen,
show locations of each on sketch.