

SHARKEY

C54

4-18-74

E Log # 80

4-18-74 19
date well completed

MISSISSIPPI
BOARD OF WATER COMMISSIONERS
416 North State Street
Jackson, Mississippi 39201

CODED

WATER WELL DRILLERS LOG

Jefcoat Drilling Co. Sharkey
firm name county well located

LANDOWNER:

John J. Long
Rolling Rock Farm
(mailing address)

description of formations
encountered

from

to

WELL LOCATION:

sec. 17 T. 13 N R. 6 W
8
1/4 miles NW of Bogalusa
(distance) (direction) (nearest town)


WELL PURPOSE: Farm
(home, irrigation, municipal, industrial)

WELL COMPLETION DATA:

- (1) diameter (inches) 4x2
- (2) total depth (feet) 1840
- (3) static water level (feet) ^{above} ~~below~~ top of ground. 1795
- (4) casing black steel 1795
(material) (depth)
2 1/2" if telescope see back.
(size)
- (5) screen 40 ft. 1795
(length) (depth to top)
2" stainless steel
(size) (material)
- (6) pump none 60
(HP) (yield gpm)
none
(type power)
- (7) electric log yes
(yes or no)
M. G. S.
(organization running log)
- (8) how well bottom plugged stuffed
1/2 gal. sand

shale + topsoil	0	56
sand	56	100
gravel	100	137
shale	137	218
sand	218	480
shale	480	664
sand fine	664	680
shale	680	715
shale	715	762
sandy shale	762	830
shale	830	880
sand very fine	880	1000
broken pipe	1000	1085
shale	1085	1541
sand fine	1541	1582
shale	1582	1693
sand	1693	1845

CODED

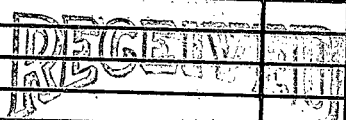


DRILLERS REMARKS:

If well telescopes please sketch and show depths.

FLP 2-2" valves
4 X 2 swedge

GROUND LEVEL

150ft + 4"

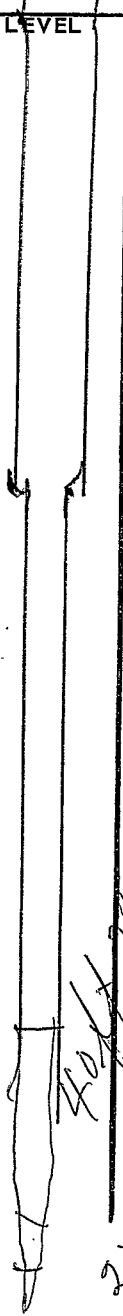

SECTION 17

Please indicate well location X.

ADDITIONAL INFORMATION

Horizontal lines for recording additional information.

If more than one screen, show locations of each on sketch.