

SHARKEY

~~6-25-74~~
C55
6-25-74

MISSISSIPPI
BOARD OF WATER COMMISSIONERS
416 North State Street
Jackson, Mississippi 39201

CODED

WATER WELL DRILLERS LOG

Sharkey
~~Wash.~~

6-25-74 date well completed 19 OWENS plbg + Htg. firm name Wash. county well located

LANDOWNER: IRA Holmes
Rt 1. Box 344
Rolling Fork, MS.
(mailing address)


WELL LOCATION:
sec. 11 T 13 N S R 7 W E
5 miles N of Rolling Fork
(distance) (direction) (nearest town)

WELL PURPOSE: Home
(home, irrigation, municipal, industrial)

- WELL COMPLETION DATA:
- (1) diameter (inches) 2"
 - (2) total depth (feet) 409'
 - (3) static water level (feet) 16" below top of ground.
 - (4) casing Galv. 399'
(material) (depth)
 - (size) If telescope see back.
 - (5) screen 10' 409'
(length) (depth to top)
 - 2" S.S.
(size) (material)
 - (6) pump 1/2 12
(HP) (yield gpm)
 - Electric
(type power)
 - (7) electric log NO.
(yes or no)
 - (organization running log)
 - (8) how well bottom plugged S.B.

description of formations encountered	from	to
top soil	0	20'
clay	20	62'
sand & gravel	62	125'
sand & rock	125	146'
clay	146	187'
sand & gravel	187	250'
sand	250	409'

CODED

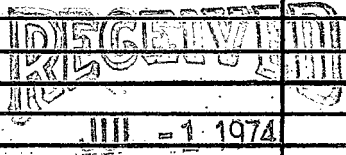


MISS. BD. OF WATER COMMISSIONERS

DRILLERS REMARKS: Owens

If well telescopes please sketch and show depths.

GROUND LEVEL

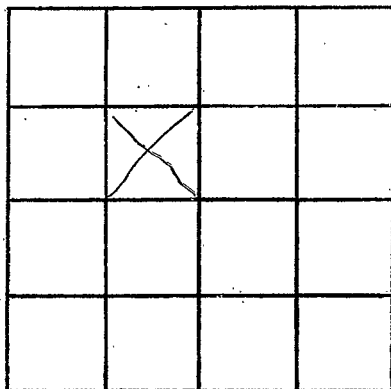

SECTION _____

Please indicate well location X.

ADDITIONAL INFORMATION

If more than one screen, show locations of each on sketch.