

MISSISSIPPI  
BOARD OF WATER COMMISSIONERS  
416 North State Street  
Jackson, Mississippi 39201

CODED

WATER WELL DRILLERS LOG

Sharkey  
C58  
12-67

date well completed 12/19 1967 firm name Bailey Drilling Co. county well located Sharkey

LANDOWNER: Mrs. Rebekah Fields  
Rolling Fork  
Miss.  
(mailing address)

WELL LOCATION:  
sec. 30 T. 13 N R. 6 E  
2 1/2 miles N of Rolling Fork  
(distance) (direction) (nearest town)


WELL PURPOSE: Home  
(home, irrigation, municipal, industrial)

WELL COMPLETION DATA:

- (1) diameter (inches) 4x3x2 1/2
- (2) total depth (feet) 925
- (3) static water level (feet) 18 below top of ground.
- (4) casing Steel  
(material), (depth)  
4x3x2 1/2 if telescope see back.  
(size)
- (5) screen 30', 895  
(length), (depth to top)  
2 1/2", stainless steel  
(size), (material)
- (6) pump 1 1/2 25  
(HP), (yield gpm)  
elec  
(type power)
- (7) electric log No  
(yes or no)  
(organization running log)
- (8) how well bottom plugged back pressure valve

| description of formations encountered | from | to  |
|---------------------------------------|------|-----|
|                                       | Clay | 0   |
| Sand                                  | 30   | 70  |
| Gravel                                | 80   | 131 |
| Mud                                   | 131  | 240 |
| Sand                                  | 240  | 300 |
| Mud                                   | 300  | 370 |
| Sand + Mud                            | 370  | 392 |
| Rock                                  | 392  | 393 |
| Sand + Mud                            | 393  | 410 |
| Mud                                   | 410  | 630 |
| Rock                                  | 630  | 631 |
| Mud                                   | 631  | 651 |
| Rock                                  | 651  | 652 |
| Mud                                   | 652  | 820 |
| Sand                                  | 820  | 845 |
| Mud                                   | 845  | 867 |
| Sand                                  | 867  | 925 |

CODED

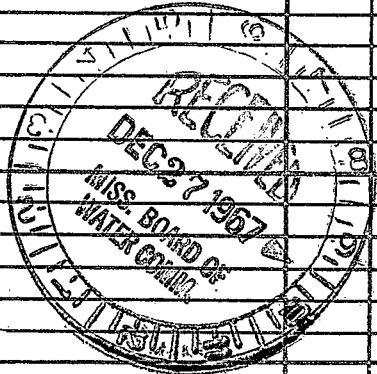

DRILLERS REMARKS:

