

SHARKEY

MISSISSIPPI
BOARD OF WATER COMMISSIONERS
416 North State Street
Jackson, Mississippi 39201

WATER WELL DRILLERS LOG CODED

SHARKEY
C59
3-68

3-124 1968 Dyer Well & Irrig., date well completed firm name county well located

LANDOWNER: F.W. CLINKSCALES
R.R.

description of formations encountered	from	to
CLAY	0	15
HARD BLUE CLAY	15	33
FINE SAND	33	53
COARSE SAND + GRA.	53	63
MED. SAND	63	73
COARSE SAND + GRA.	73	83
FINE SAND	83	103
MED. SAND	103	113

HOLLANDALE, MISS.
(mailing address)


WELL LOCATION:
sec. 1 T. 13 N R. 17 E
4 1/2 miles NW of ANCHILUA
(distance) (direction) (nearest town)

WELL PURPOSE: IRRIGATION
(home, irrigation, municipal, industrial)

WELL COMPLETION DATA:

- (1) diameter (inches) 16"
- (2) total depth (feet) 113'
- (3) static water level (feet) 17' below top of ground.
- (4) casing (material) IRON, (depth) 73'
- (5) screen (length) 40', (depth to top) 73'
(size) 16" BLK IRON (material)
- (6) pump 60 (HP), 3000 (yield gpm)
DIESEL (type power)
- (7) electric log No (yes or no)
(organization running log)
- (8) how well bottom plugged None

CODED

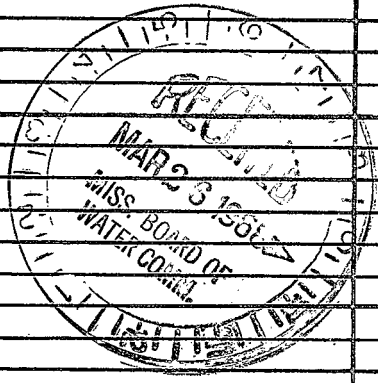

DRILLERS REMARKS:

If well telescopes please sketch and show depths.

GROUND LEVEL

X			

SECTION 1

Please indicate well location X.

ADDITIONAL INFORMATION

If more than one screen,
show locations of each on sketch.