


Shackey
C 60
6-08

MISSISSIPPI
BOARD OF WATER COMMISSIONERS
416 North State Street
Jackson, Mississippi 39201
WATER WELL DRILLERS LOG

CODED

June 15 1968 M.C. Connell Drilling Co. Shackey
date well completed firm name county well located

LANDOWNER: W. B. THOMASON JR.
Anguilla Miss
Dry Bend Plantation
(mailing address)

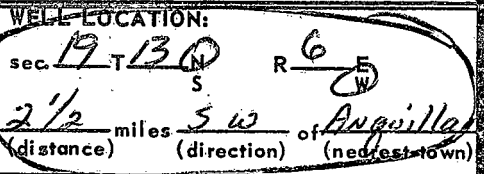

WELL PURPOSE: Home & Farm
(home, irrigation, municipal, industrial)

WELL COMPLETION DATA:

- (1) diameter (inches) 4" x 2"
- (2) total depth (feet) 987'
- (3) static water level (feet) 19 below top of ground.
- (4) casing steel, 957' (material) (depth)
(size) if telescope see back.
- (5) screen 30', 957' (length) (depth to top)
3" 5.5 steel (size) (material)
- (6) pump 1 1/2 HP, 25 (yield gpm)
elect. (type power)
- (7) electric log No (yes or no)
(organization running log)
- (8) how well bottom plugged back wash valve.

Description of formations encountered	from	to
Top Soil	0	26
sand & clay	26	49
sand & pea gravel	49	112'
sand & clay	112'	309
sand, (Good coarse)	309	505
sandy clay with sand breaks.	505	896
Rock (8 hrs to drill)	896	900
Sand (Good)	900	987


CODED

JUN 20 1968
MISS. BOARD OF WATER COMMISSIONERS

DRILLERS REMARKS: Drilled very little clay. Had to mix Gel to keep any viscosity to T.D.

If well telescopes please sketch and show depths.

GROUND LEVEL

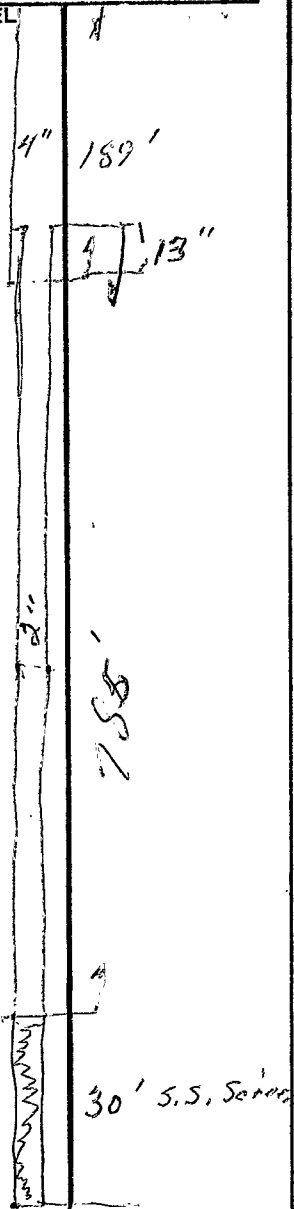

SECTION _____

Please indicate well location X.

ADDITIONAL INFORMATION

well is 2 1/2 miles South
& 2 miles west of
Anquilla Miss.

If more than one screen,
show locations of each on sketch.