

SHARKEY  
C63  
Elog #93

MISSISSIPPI  
BOARD OF WATER COMMISSIONERS  
416 North State Street  
Jackson, Mississippi 39201

CODED

WATER WELL DRILLERS LOG

July 20 1977 E.M. "Bud" CRESSWELL Sharkey  
 date well completed firm name county well located

LANDOWNER: Jackie MARTIN  
 Anguilla, Ms.  
 (mailing address)

WELL LOCATION:  
 sec. 1 T. 13N R. 6 W  
 3 miles EAST of Anguilla  
 (distance) (direction) (nearest town)

description of formations encountered	from	to
Clay	0	60
Sandy gravel	60	260
Sand	260	380
Sandy shale	380	600
Shale	600	760
Sand	760	840

WELL PURPOSE: home  
 (home, irrigation, municipal, industrial)

WELL COMPLETION DATA:

(1) diameter (inches) 4

(2) total depth (feet) 840

(3) static water level (feet) 18 below top of ground.

(4) casing steel (material) (depth) 4 (size) If telescope see back.

(5) screen 20 820 (length) (depth to top) 2 STAINLESS (size) (material)

(6) pump 1 30 (HP) (yield gpm) 0 (type power)

(7) electric log yes (yes or no) State (organization running log)

CODED

(8) how well bottom plugged steel plug


DRILLERS REMARKS:

RECEIVED  
AUG 12 1977

MISS. BD. OF WATER COMM.

If well telescopes please sketch and show depths.

GROUND LEVEL

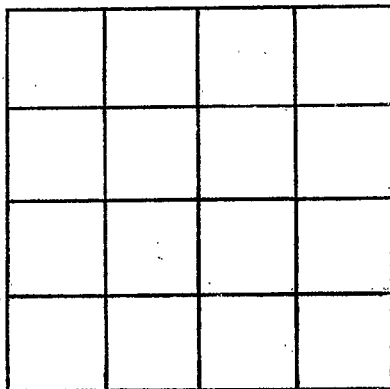

SECTION \_\_\_\_\_

Please indicate well location X.

ADDITIONAL INFORMATION

If more than one screen, show locations of each on sketch.