

SHARKEY
C 64
7-25-77

MISSISSIPPI
 BOARD OF WATER COMMISSIONERS
 416 North State Street
 Jackson, Mississippi 39201 **CODED**

WATER WELL DRILLERS LOG

7-25 1977 Layne Central Company Sharkey
 date well completed firm name county well located

LANDOWNER: Sam Harris
 Rt. 1, Box 176
 Rolling Fork, MS

(mailing address)

WELL LOCATION:

sec. 23 T. 13 N R. 7 W
 6.9 ± miles NW of Anguilla
 (distance) (direction) (nearest town)

WELL PURPOSE: Irrigation
 (home, irrigation, municipal, industrial)

WELL COMPLETION DATA:

- (1) diameter (inches) 12"
- (2) total depth (feet) 112'
- (3) static water level (feet) 12' below top of ground.
- (4) casing Steel 79' 5" (material) (depth)
 12" (size) if telescope see back.
- (5) screen 40' 72' (length) (depth to top)
 10" St. Steel (size) (material)
- (6) pump 20 1,000 (HP) (yield gpm)
 diesel (type power)
- (7) electric log No (yes or no)
- (organization running log)
- (8) how well bottom plugged St. Plate

description of formations encountered

from

to

Clay	0	19
Fine Sand	19	64
Coarse Sand	64	106
Boulders	106	112


CODED

RECEIVED

SEP 18 1977

If well telescopes please sketch and show depths.

GROUND LEVEL

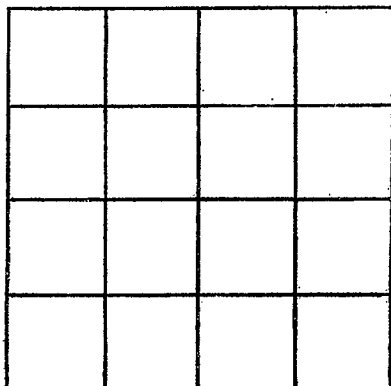

SECTION _____

Please indicate well location X.

ADDITIONAL INFORMATION

If more than one screen, show locations of each on sketch.