

irrigation
MISSISSIPPI
BOARD OF WATER COMMISSIONERS
 416 North State Street
 Jackson, Mississippi 39201

CODED

WATER WELL DRILLERS LOG

Sharkey
C 65
8-1-77

8-1 1977 Dyer Well & Irrigation Sharkey
 date well completed firm name county well located

LANDOWNER: Harvey Thompson
 P.O. Box 12282
Jackson, Miss.
 (mailing address)

description of formations encountered	from	to
Clay	0	40
Fine Sand	44	48
Sand + Gravel	48	103

WELL LOCATION:
 sec. 36 T. 13 N. R. 6 E
6 miles SE of Anguilla
 (distance) (direction) (nearest town)

CODED

WELL PURPOSE: Irrigation
 (home, irrigation, municipal, industrial)

WELL COMPLETION DATA:

(1) diameter (inches) 12"

(2) total depth (feet) 103'

(3) static water level (feet) 24' below above top of ground.

(4) casing Steel, 63'
 (material) (depth)
12" if telescope see back.
 (size)

(5) screen 40', 63'
 (length) (depth to top)
12", Steel
 (size) (material)

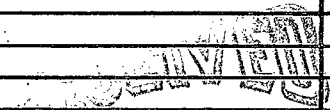
(6) pump 30, 140-1500
 (HP) (yield gpm)

Tractor
 (type power)

(7) electric log No
 (yes or no)

(organization running log)

(8) how well bottom plugged Plate


 SEP 28 1977

DRILLERS REMARKS:

MISS. RD. OF WATER COMMISSIONERS

