

Sharkey
C 75
8-7-80

MISSISSIPPI
BOARD OF WATER COMMISSIONERS
416 North State Street
Jackson, Mississippi 39201

CODED

Well # I

WATER WELL DRILLERS LOG

8-7-80 19 Dreiling & Associates Sharkey
date well completed firm name county well located

This desc. would be in DeSogreana Co.

LANDOWNER: Hermon Farms
Jimmy Hermon
(mailing address)

description of formations encountered	from	to
Clay Top Soil	0	5
Clay	5	10
Clay	10	15
Clay	15	20
Clay	20	25
Clay	25	30
Clay	30	35
Sand Fine	35	40
Sand & Clay	40	45
Sand & Clay	45	50
Sand & Gravel	50	55
Sand & Gravel	55	60
Sand & Gravel	60	65
Sand & Gravel	65	70
Sand & Gravel	70	75
Sand & Gravel	75	80
Sand & Gravel	80	85
Gravel	85	90
Gravel	90	95
Gravel	95	100
Gravel	100	105
Gravel	105	110
Gravel Bottom of Hole 114"	110	115

WELL LOCATION:
sec. 18 T. 13 N R. 7 E
S W
5. W-4 N miles 7 NW of R.F. Ms.
(distance) (direction) (nearest town)

WELL PURPOSE: Catfish Pond
(home, irrigation, municipal, industrial)

- WELL COMPLETION DATA:
- (1) diameter (inches) 22"
 - (2) total depth (feet) 114'
 - (3) static water level (feet) 20' ^(below) _(above) top of ground.
 - (4) casing Steel, 114'
(material) (depth)
____ if telescope see back.
(size)
 - (5) screen 40', 74'
(length) (depth to top)
16", Steel
(size) (material)
 - (6) pump 60 3800
(HP) (yield gpm)
Diesel
(type power)
 - (7) electric log NO
(yes or no)
 - (8) how well bottom plugged Steel Plug


DRILLERS REMARKS: Water table
drop in pumping level
increased by 20'

DEPT. OF NATURAL RESOURCES
BUREAU OF LAND & WATER RESOURCES

SEP 20 1980
RECEIVED

If well telescopes please sketch and show depths.

GROUND LEVEL

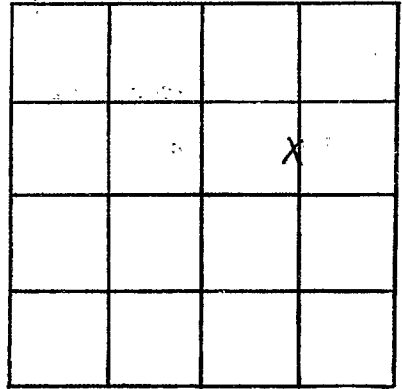

SECTION _____

Please indicate well location X.

ADDITIONAL INFORMATION

If more than one screen, show locations of each on sketch.