

Bureau of Land and Water Resources

Southport Mall

P.O. Box 10631

Jackson, Mississippi 39209

WATER WELL DRILLERS LOG

CODED

Sharky

CTT

2-3-81

0036

2/3

1981

Dgn

Sharky

date well completed

firm name

county well located

LANDOWNER:

Joel Hill

NITA HUMA MB
(mailing address)

description of formations encountered

from

to

Clay	0	30
Fine Sand	28	38
Sand + Clay	38	68
Sand + Gravel + Clay	68	113

WELL LOCATION:

sec. 12 T. 13 N. R. 6 E. S. 1
 (distance) milos (direction) (nearest town) Nita Yuma


WELL PURPOSE: (home, irrigation, municipal, industrial)

Irrigation

WELL COMPLETION DATA:

- (1) diameter (inches) 16"
- (2) total depth (feet) 113'
- (3) static water level (feet) 21' below top of ground.
- (4) casing (material) Steel (depth) 113' (size) 16" If telescopic see back.
- (5) screen (length) 40' (depth to top) 73' (size) 16" (material) Steel
- (6) pump (HP) 60 (yield gpm) 3000 (type power) Diesel
- (7) electric log (yes or no)
- (organization running log)
- (8) how well bottom plugged plate

CODED

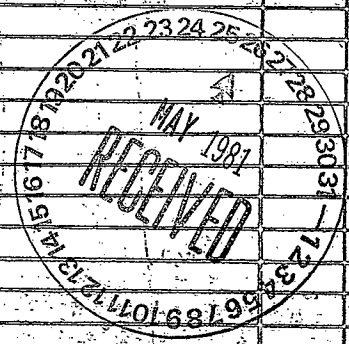


DRILLERS REMARKS:

Dot allsup

Sam Jo, ms

wills

40 gpm

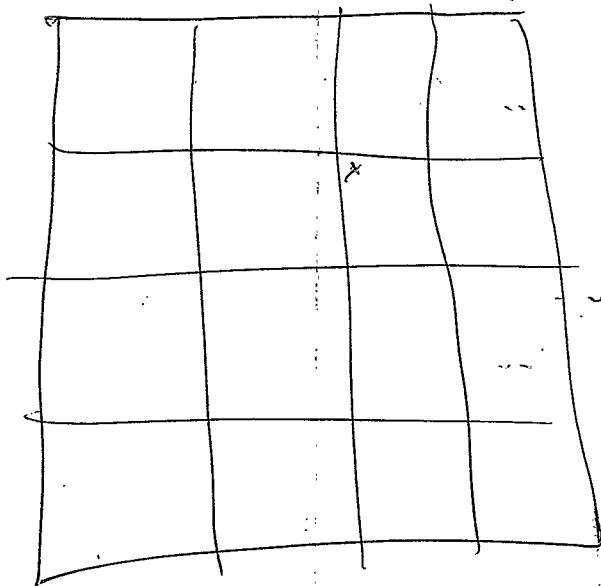

see 12