

CODED

WATER WELL DRILLERS LOG

Sharkey

C 78

9-26-80

9/26

1980

Dyer

Sharkey

date well completed

firm name

county well located

LANDOWNER:

BILLY MCKINNEY

Anguilla, MS.
(mailing address)

description of formations encountered

from to

Clay	0	38
Sand sand	38	48
Sand	48	50
Sand & Gravel	50	113

WELL LOCATION:

sec 28 T 130 R 6 E
7 miles S of Anguilla
 (distance) (direction) (nearest town)


WELL PURPOSE: Irrigation
 (home, irrigation, municipal, industrial)

WELL COMPLETION DATA:

- (1) diameter (inches) 16 inches
- (2) total depth (feet) 113'
- (3) static water level (feet) 18' below above top of ground.
- (4) casing Steel 113'
 (material) (depth)
- 16" if telescope see-back.
 (size)
- (5) screen 40' 73'
 (length) (depth to top)
- 16" Steel
 (size) (material)
- (6) pump 60 3000
 (HP) (yield gpm)
- Diesel
 (type power)
- (7) electric log (yes or no) _____
 (organization running log) _____
- (8) how well bottom plugged Plate

CODED

DRILLERS REMARKS:

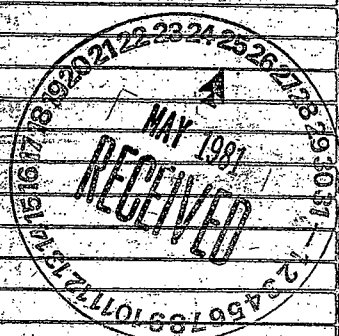

A hand-drawn grid consisting of 4 columns and 4 rows. The grid is slightly irregular in shape. An 'X' is drawn in the top-right cell of the grid.

			X

see 28