

BOARD OF WATER COMMISSIONERS
416 North State Street
Jackson, Mississippi 39201

320

CODED

WATER WELL DRILLERS LOG

Sharkey
C 79
10-3-80
10/3

1980

Dyer
firm name

Sharkey
county well located

LANDOWNER:

BILLY MCKINNEY

Osguilla MS
(mailing address)

WELL LOCATION:

sec. 28 T. 13 N. R. 6 E. S. 5 W.
2 miles (distance) S (direction) of Osguilla (nearest town)

WELL PURPOSE: Irrigation
(home, irrigation, municipal, industrial)

WELL COMPLETION DATA:

- (1) diameter (inches) 16"
- (2) total depth (feet) 113'
- (3) static water level (feet) 18' below top of ground
- (4) casing Steel 113' (material) (depth)
16" (size) if telescopic see back.
- (5) screen 40' 73' (length) (depth to top)
16" (size) Steel (material)
- (6) pump 60 3000 (HP) (yield gpm)
Diesel (type power)
- (7) electric log (yes or no)
- (8) how well bottom plugged plate


Description of formations encountered

from to

Clay	0	70
Sand	40	60
Sand & Gravel + Clay	60	90
Sand & Gravel	90	113

CODED

DRILLERS REMARKS:

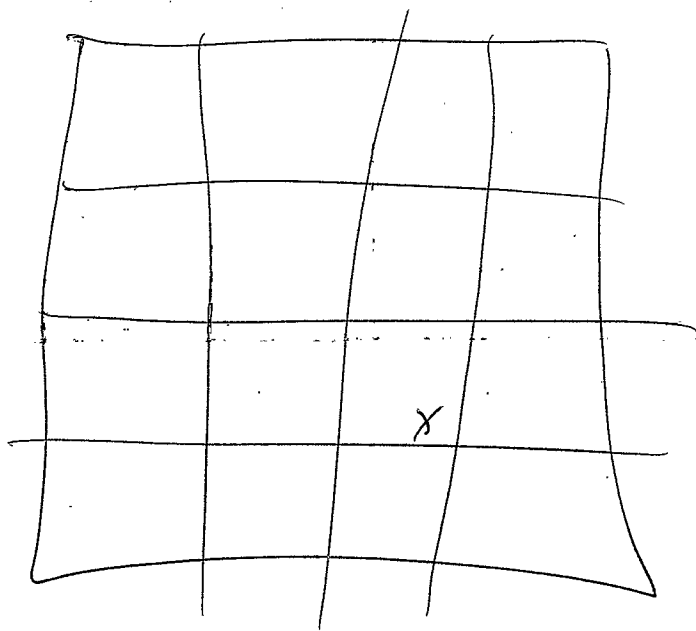

See 28