

MISSISSIPPI  
BOARD OF WATER COMMISSIONERS  
416 North State Street  
Jackson, Mississippi 39201

CODED

WATER WELL DRILLERS LOG

Sharkey  
C 81  
422-80

date well completed 4.22 1980 firm name Dyer county well located Sharkey

LANDOWNER: JOEL HILL  
CAMETA  
Mitta Yuma (mailing address) MS.  
WELL LOCATION:  
sec. 2 T. 130 N. R. 2 E.  
2.5 miles NW of Arvilla  
(distance) (direction) (nearest town)


description of formations encountered	from	to
Clay	0	28
fine sand	28	38
sand	38	45
sand gravel	45	113

WELL PURPOSE: Irrigation  
(home, irrigation, municipal, industrial)

CODED


WELL COMPLETION DATA:  
(1) diameter (inches) 16"  
(2) total depth (feet) 113"  
(3) static water level (feet) 17' below top of ground.  
(4) casing Steel 113'  
(material) (depth)  
16" if telescope see back.  
(size)  
(5) screen 40' 73'  
(length) (depth to top)  
16" Steel  
(size) (material)  
(6) pump 60 3000  
(HP) (yield gpm)  
Diesel  
(type power)  
(7) electric log (yes or no)  
(organization running log)  
(8) how well bottom plugged plate

DRILLERS REMARKS:

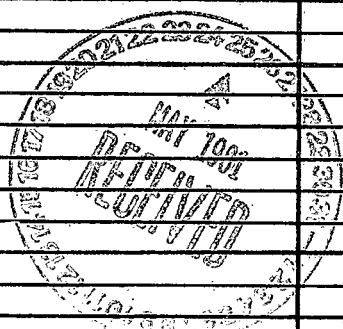

If well telescopes please sketch and show depths.

GROUND LEVEL

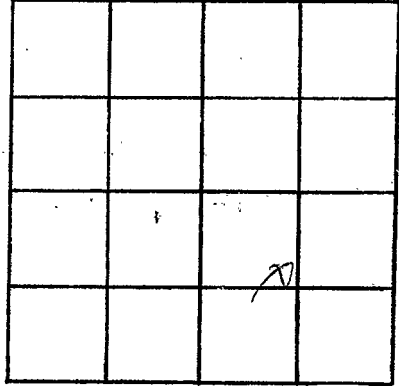

SECTION 2

Please indicate well location X.

ADDITIONAL INFORMATION

If more than one screen, show locations of each on sketch.