

Sharky
C82
6-11-81

MISSISSIPPI DEPARTMENT OF NATURAL RESOURCES
Bureau of Land and Water Resources
Southport Mall
P.O. Box 10631
Jackson, Mississippi 39209
WATER WELL DRILLERS LOG

CODED
CODED

6-11-81 date well completed 1981 Dyer Well & Irrigation firm name Sharky county well located

LANDOWNER:
Bill C. Cimbocales
Angeilla, MS.
(mailing address)

description of formations encountered	from	to
clay	0	32
fine sand	32	37
clay	37	42
sand & gravel	42	97

WELL LOCATION:
sec. 1 T 13 N R 6 E
S W
4 miles NE of Angeilla
(distance) (direction) (nearest town)

WELL PURPOSE:
(home, irrigation, municipal, industrial)

WELL COMPLETION DATA:

(1) diameter (inches) 16

(2) total depth (feet) 97

(3) static water level (feet) 20' below top of ground.

(4) casing Steel 97' (material) (depth)
16" (size) if telescope see back.

(5) screen 40' 57' (length) (depth to top)
16" Steel (size) (material)


(6) pump 80 1200 (HP) (yield gpm)
Diesel (type power)

(7) electric log (yes or no)

(organization running log)

(8) how well bottom plugged plate


CODED

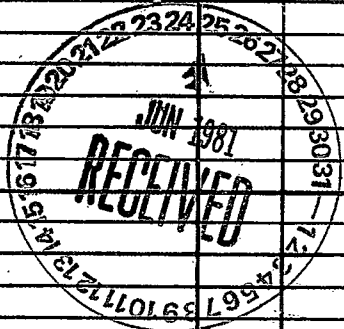

DRILLERS REMARKS:

If well telescopes please sketch and show depths.

GROUND LEVEL

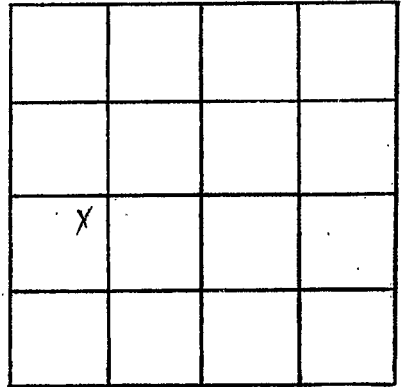

SECTION 1

Please indicate well location X.

ADDITIONAL INFORMATION

If more than one screen, show locations of each on sketch.