

Sharkey
 C 83
 7-81


MISSISSIPPI
 BOARD OF WATER COMMISSIONERS
 416 North State Street
 Jackson, Mississippi 39201

CODED

WATER WELL DRILLERS LOG


July 19 *81* *Drilling & Assoc.* *Sharkey*
 date well completed firm name county well located

LANDOWNER:	description of formations encountered	from	to
<i>Frank Prewett</i>			
<i>Rolling Fork, MS</i> (mailing address) <i>39159</i>	Clay	5	10
WELL LOCATION: sec. <i>19</i> T <i>13</i> (N) R <i>7</i> E <i>3</i> miles <i>W</i> of <i>Rolling Fork</i> (distance) (direction) (nearest town)	Blue Clay	10	15
WELL PURPOSE: (home, irrigation, municipal, industrial)	Clay	15	20
WELL COMPLETION DATA: (1) diameter (inches) <i>12"</i>	Clay	20	25
(2) total depth (feet) <i>114'</i>	Clay	25	30
(3) static water level (feet) <i>18</i> ^{below} top of ground.	Fine Sand	30	35
(4) casing <i>steel</i> , <i>84'</i> (material) (depth)	Fine Sand	35	40
(size) If telescope see back.	Fine Sand	40	45
(5) screen <i>40'</i> (length) (depth to top)	Fine & Med. Sand	45	50
<i>12"</i> , <i>STEEL</i> (size) (material)	Fine & Med. Sand	50	55
(6) pump <i>25</i> <i>1700</i> (HP) (yield gpm)	Fine & Med. Sand	55	60
<i>Pro name</i> (type power)	Fine & Med. Sand & Gravel	60	65
(7) electric log <i>NO</i> (yes or no)	Fine & Med. Sand & Gravel	65	70
(organization running log)	Fine & Med. Sand & Gravel	70	75
(8) how well bottom plugged <i>STEEL</i> <i>Plug</i>	Coarse Sand & Gravel	75	80
DRILLERS REMARKS:	Coarse Sand & Gravel	80	85
	Coarse Sand & Gravel	85	90
	Coarse Sand & Gravel	90	95
	Coarse Sand & Gravel	95	100
	Coarse Sand & Gravel	100	105
	Coarse Sand & Gravel	105	110
	Coarse Sand & Gravel	110	115
	Clay	115	120
	Bottom of Hole	120	125

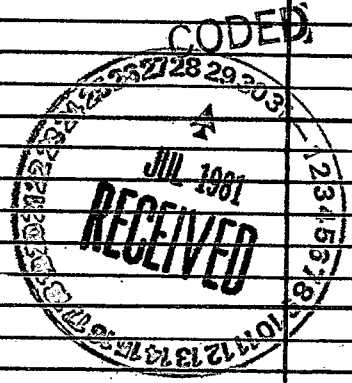

If well telescopes please sketch and show depths.

GROUND LEVEL

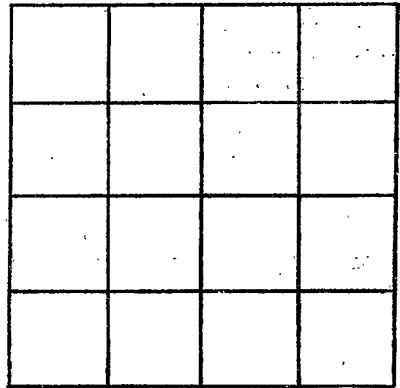

SECTION _____

Please indicate well location X.

ADDITIONAL INFORMATION

If more than one screen, show locations of each on sketch.