

MISSISSIPPI DEPARTMENT OF NATURAL RESOURCES

Bureau of Land and Water Resources

Southport Mall

P.O. Box 10631

Jackson, Mississippi 39209


WATER WELL DRILLERS LOG CODED

Sharkey
C 84
21-24-81

March 24 1981 date well completed Lamp Well & Pump firm name Sharkey county well located


LANDOWNER: <u>V. F. Phillips</u>	description of formations encountered	from	to
<u>Anguilla ms.</u> (mailing address)	<u>CLAY</u> <u>MED & FINE SAND</u> <u>COARSE SAND</u>	<u>0</u> <u>40</u> <u>80</u>	<u>60</u> <u>80</u> <u>123</u>
WELL LOCATION: sec. <u>1</u> T. <u>13</u> N. R. <u>6</u> E W <u>7</u> miles <u>NE</u> of <u>Anguilla</u> (distance) (direction) (nearest town)			
WELL PURPOSE: (home, irrigation, municipal, industrial)			
WELL COMPLETION DATA: (1) diameter (inches) <u>16"</u> (2) total depth (feet) <u>123'</u> (3) static water level (feet) <u>16</u> below above top of ground. (4) casing <u>Steel</u> , <u>83'</u> (material) (depth) (size) if telescope see back. (5) screen <u>40'</u> , <u>83'</u> (length) (depth to top) <u>16"</u> , <u>Steel</u> (size) (material) (6) pump <u>60</u> , <u>3000</u> (HP) (yield gpm) (type power) (7) electric log <u>No</u> (yes or no) (organization running log) (8) how well bottom plugged <u>Steel Plate</u>			
DRILLERS REMARKS:			

CODED

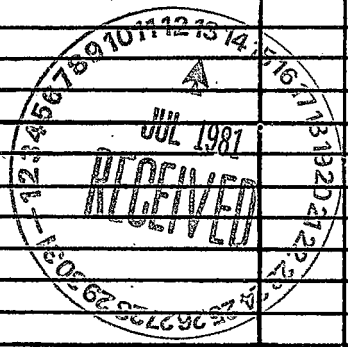

If well telescopes please sketch and show depths.

GROUND LEVEL

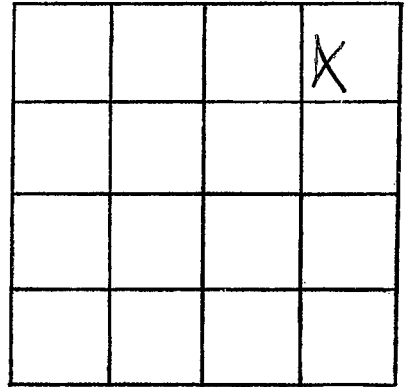

SECTION 1

Please indicate well location X.

ADDITIONAL INFORMATION

If more than one screen,
show locations of each on sketch.