

MISSISSIPPI DEPARTMENT OF NATURAL RESOURCES

Bureau of Land and Water Resources

Southport Mall

P.O. Box 10631

Jackson, Mississippi 39209

WATER WELL DRILLERS LOG


CODED

Shorkey
C 85
4-27-81

date well completed April 27, 1981 firm name Larry's Well & Pump county well located Shorkey

LANDOWNER: <u>Raymond Brown</u>	description of formations encountered	from	to
<u>Anguilla, Miss</u> (mailing address)	<u>CLAY</u> <u>FINE SAND</u> <u>COARSE SAND</u>	<u>0</u>	<u>50</u>
WELL LOCATION: sec. <u>22</u> T <u>13</u> N R. <u>6</u> E <u>2 1/2</u> miles <u>E</u> of <u>Anguilla</u> (distance) (direction) (nearest town)			
WELL PURPOSE: (home, irrigation, municipal, industrial)			
WELL COMPLETION DATA:			
(1) diameter (inches) <u>16"</u>			
(2) total depth (feet) <u>116'</u>			
(3) static water level (feet) <u>22</u> below above top of ground.			
(4) casing <u>Steel</u> , <u>76'</u> (material) (depth) (size) if telescope see back.			
(5) screen <u>40'</u> , <u>76'</u> (length) (depth to top) <u>16'</u> , <u>steel</u> (size) (material)			
(6) pump <u>100</u> , <u>3000</u> (HP) (yield gpm) (type power)			
(7) electric log <u>No</u> (yes or no)			
(organization running log)			
(8) how well bottom plugged <u>Steel Plate</u>			
DRILLERS REMARKS:			

CODED

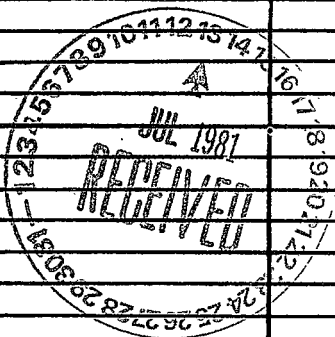

If well telescopes please sketch and show depths.

GROUND LEVEL

		X	

SECTION 22

Please indicate well location X.

ADDITIONAL INFORMATION

If more than one screen,
show locations of each on sketch.