

MISSISSIPPI DEPARTMENT OF NATURAL RESOURCES

Bureau of Land and Water Resources

Southport Mall

P.O. Box 10631

Jackson, Mississippi 39209

WATER WELL DRILLERS LOG

CODED

Dyer well

Sharkey
Issaquena

SHARKEY
C 89
4/83

19 _____ date well completed
_____ firm name
_____ county well located

LANDOWNER: *Carter Bros*
Rolling Fork

(mailing address)

WELL LOCATION:
sec *35* T *13* N R *7* E
S
_____ miles *N* of *Rolling Fork*
(distance) (direction) (nearest town)

description of formations encountered	from	to
<i>Clay</i>	<i>7</i>	<i>38</i>
<i>Fine Sand</i>	<i>38</i>	<i>58</i>
<i>Sand</i>	<i>58</i>	<i>68</i>
<i>Fine Sand</i>	<i>68</i>	<i>86</i>
<i>Sand + Gravel</i>	<i>86</i>	<i>98</i>
<i>Fine Sand</i>	<i>98</i>	<i>136</i>
<i>Sand + Gravel</i>	<i>136</i>	<i>155</i>
<i>Fine Sand</i>	<i>155</i>	<i>163</i>

WELL PURPOSE:
(home, irrigation, municipal, industrial)

WELL COMPLETION DATA:
 (1) diameter (inches) *16*
 (2) total depth (feet) *163*
 (3) static water level (feet) *10* below above top of ground.
 (4) casing *Steel, 123,*
 (material) (depth)
 _____ if telescope see back.
 (size)
 (5) screen *40'*
 (length) (depth to top)
16" *steel*
 (size) (material)
 (6) pump *60* *3000*
 (HP) (yield gpm)
diesel
 (type power)
 (7) electric log *no*
 (yes or no)

 (organization running log)

CODED
DEPT. OF NATURAL RESOURCES BUREAU OF LAND & WATER RESOURCES
MAY 9 1993


(8) how well bottom plugged *plate*

DRILLERS REMARKS:

RECEIVED

If well telescopes please sketch and show depths.

GROUND LEVEL

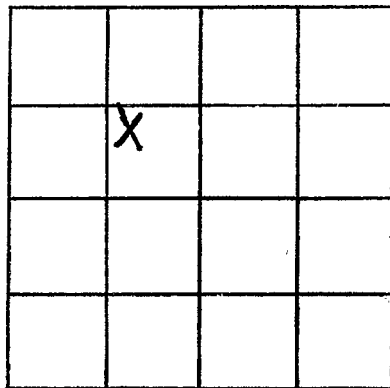

SECTION 35

Please indicate well location X.

ADDITIONAL INFORMATION

If more than one screen,
show locations of each on sketch.