

MISSISSIPPI DEPARTMENT OF NATURAL RESOURCES

Bureau of Land and Water Resources

Southport Mall

P.O. Box 10631

Jackson, Mississippi 39209

WATER WELL DRILLERS LOG

CODED

Sharkey
C 90
4/13/82

date well completed April 13, 1982 firm name Larry's well & pump county well located Sharkey

LANDOWNER: Bill Clark

description of formations encountered from to

Delta city, Miss
 (mailing address)

0-18 clay
18-35 fine sand
35-50 med. sand
50-120 coarse sand

WELL LOCATION:
 sec. 11 T. 13 N R. 6 W
5 miles NE of Anguille
 (distance) (direction) (nearest town)

WELL PURPOSE:
 (home, irrigation, municipal, industrial)

WELL COMPLETION DATA:

- (1) diameter (inches) 16"
- (2) total depth (feet) 120'
- (3) static water level (feet) 22 below above top of ground.
- (4) casing Steel, 80'
 (material) (depth)
 (size) if telescope see back.
- (5) screen 40' 80'
 (length) (depth to top)
16" steel
 (size) (material)
- (6) pump 60 2800
 (HP) (yield gpm)
DSL Power unit
 (type power)
- (7) electric log No
 (yes or no)
 (organization running log)
- (8) how well bottom plugged steel plate

CODED

DEPT. OF NATURAL RESOURCES
 BUREAU OF LAND & WATER RESOURCES


JUN 30 1982

RECEIVED

DRILLERS REMARKS:

If well telescopes please sketch and show depths.

GROUND LEVEL

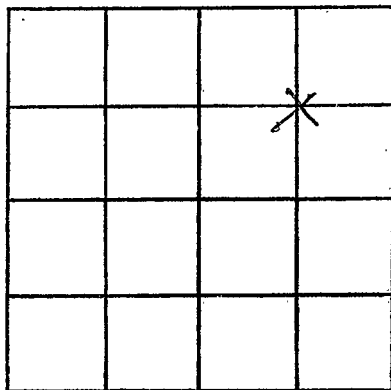

SECTION 11

Please indicate well location X.

ADDITIONAL INFORMATION

If more than one screen, show locations of each on sketch.