

MISSISSIPPI DEPARTMENT OF NATURAL RESOURCES

Bureau of Land and Water Resources

Southport Mall

P.O. Box 10631

Jackson, Mississippi 39209

WATER WELL DRILLERS LOG

Sharkey
C 91
4/13/82

CODED

4/13 1982 date well completed
 Larry's well & pump Sharkey film name
 county well located

LANDOWNER: Bill Clarkscales

description of formations encountered from to

Delta City, Miss (mailing address)

0-20 Clay
20-30 fine sand
30-45 med sand
45-102 coarse sand

WELL LOCATION:

sec. 11 T-13 N R-6 W
 5 miles NE of Anquilla
 (distance) (direction) (nearest town)

WELL PURPOSE:

(home, irrigation, municipal, industrial)

WELL COMPLETION DATA:

- (1) diameter (inches) 16"
- (2) total depth (feet) 102'
- (3) static water level (feet) 23 below above top of ground.
- (4) casing Steel 102' (material) (depth)

CODED

if telescope see back. (size)

- (5) screen 40' 62' (length) (depth to top)
16" Steel (size) (material)

- (6) pump 20 1200 (HP) (yield gpm)

DSL Powerunit (type power)

- (7) electric log NO (yes or no)

(organization running log)

- (8) how well bottom plugged Steel Plate


DRILLERS REMARKS:

DEPT. OF NATURAL RESOURCES BUREAU OF LAND & WATER RESOURCES

JUN 30 1982 RECEIVED

If well telescopes please sketch and show depths.

GROUND LEVEL

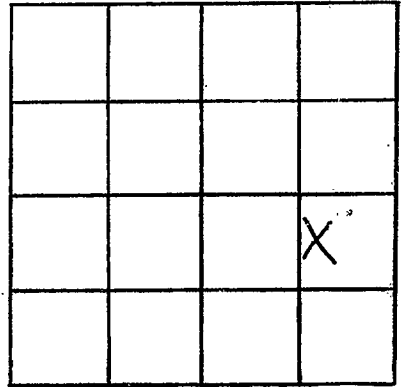

SECTION 11

Please indicate well location X.

ADDITIONAL INFORMATION

If more than one screen, show locations of each on sketch.