

MISSISSIPPI DEPARTMENT OF NATURAL RESOURCES

Bureau of Land and Water Resources

Southport Mall

P.O. Box 10631

Jackson, Mississippi 39209

WATER WELL DRILLERS LOG

Shakery
 Q 92
 8/20/82


CODED

8-20 1982 *Super Well* *Shakery*
 date well completed firm name county well located

LANDOWNER: <i>Billy McKenzer</i>	description of formations encountered	from	to
(mailing address)	<i>Clay</i>	<i>0</i>	<i>46</i>
WELL LOCATION: sec <i>28</i> T. <i>B</i> N <i>1</i> S R. <i>6</i> E <i>W</i>	<i>B. Sand & gravel</i>	<i>46</i>	<i>56</i>
<i>2</i> miles <i>SE</i> of <i>Amvil</i>	<i>Sand & gravel</i>	<i>56</i>	<i>117</i>
WELL PURPOSE: (home, irrigation, municipal, industrial)			
WELL COMPLETION DATA:			
(1) diameter (inches) <i>16</i>	CODED		
(2) total depth (feet) <i>117</i>			
(3) static water level (feet) <i>27</i> below top of ground.			
(4) casing <i>Steel</i> , <i>97</i> (material), (depth)			
<i>16</i> (size) if telescope see back.			
(5) screen <i>40'</i> , <i>40'</i> (length), (depth to top)			
<i>16</i> , <i>mid Steel</i> (size), (material)			
(6) pump <i>60</i> , <i>3000</i> (HP), (yield gpm)		DEPT. OF NATURAL RESOURCES BUREAU OF LAND & WATER RESOURCES	
<i>electric</i> (type power)	FFB - 3 1983		
(7) electric log <i>no</i> (yes or no)	RECEIVED		
<i>no</i> (organization running log)			
(8) how well bottom plugged <i>Plate</i>			
DRILLERS REMARKS:			

If well telescopes please sketch and show depths.

GROUND LEVEL

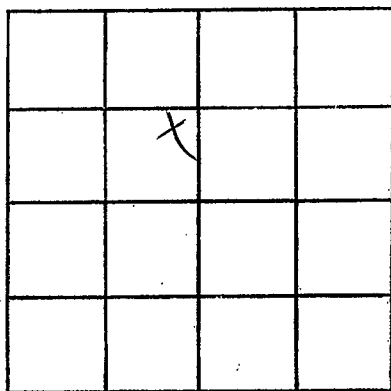

SECTION 28

Please indicate well location X.

ADDITIONAL INFORMATION

If more than one screen,
show locations of each on sketch.