

MISSISSIPPI DEPARTMENT OF NATURAL RESOURCES

Bureau of Land and Water Resources

Southport Mall

P.O. Box 10631

Jackson, Mississippi 39209

WATER WELL DRILLERS LOG

CODED

SHARKEY

C 94

8-22

19

84

Schultz Drilling

Sharkey

date well completed

firm name

county well located

LANDOWNER: Randle Atchley

Anguilla MS

(mailing address)

WELL LOCATION:

sec. 26 T. 13 N. R. 6 E. S. 4 E. of Anguilla
 (distance) (direction) (nearest town)

WELL PURPOSE: home
 (home, irrigation, municipal, industrial)

WELL COMPLETION DATA:

- (1) diameter (inches) 4" x 2"
- (2) total depth (feet) 800'
- (3) static water level (feet) 34' below top of ground.
- (4) casing galv. 780'
 (material) (depth)
- (size) If telescope see back.
- (5) screen 20' 780'
 (length) (depth to top)
 2" stainless steel
 (size) (material)
- (6) pump 1 1/2 25
 (HP) (yield gpm)
 eb
 (type power)
- (7) electric log NO
 (yes or no)
 (organization running log)
- (8) how well bottom plugged b/w

description of formations encountered

from

to

| | | |
|---------------|-----|-----|
| CLAY | 0 | 20 |
| SAND | 20 | 100 |
| SAND + GRAVEL | 100 | 215 |
| CLAY | 215 | 400 |
| SAND | 400 | 420 |
| CLAY | 420 | 600 |
| SANDY shale | 600 | 700 |
| Med SAND | 700 | 740 |
| SAND. | 740 | 800 |


CODED

DRILLERS REMARKS:

MISSISSIPPI DEPARTMENT OF NATURAL RESOURCES
 BUREAU OF LAND & WATER RESOURCES
 OCT - 9 1984
 RECEIVED

If well telescopes please sketch and show depths.

GROUND LEVEL

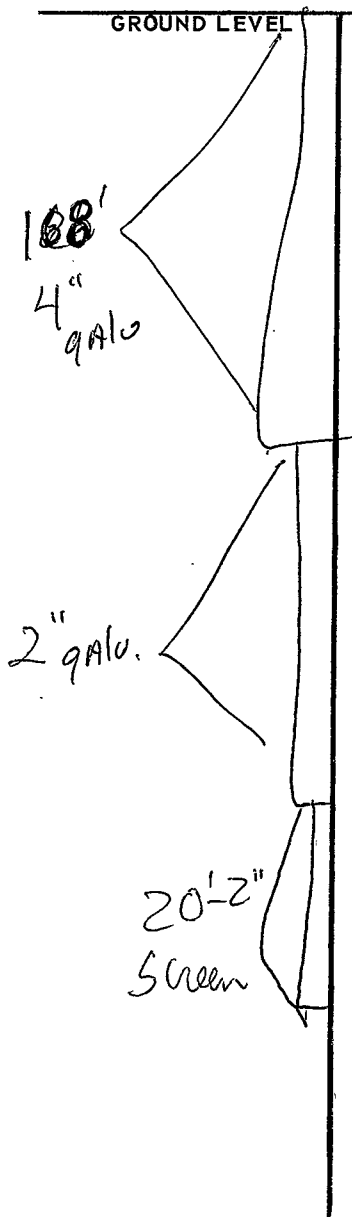

| | | | |
|---|--|--|--|
| X | | | |
| | | | |
| | | | |
| | | | |

SECTION 26

Please indicate well location X.

ADDITIONAL INFORMATION

If more than one screen, show locations of each on sketch.