

MISSISSIPPI DEPARTMENT OF NATURAL RESOURCES

Bureau of Land and Water Resources

Southport Mall

P.O. Box 10631

Jackson, Mississippi 39209

WATER WELL DRILLERS LOG

JEP
08031-LAR-04-88
SHARKEY
C 100

Coded

10-30 1987
date well completed

87 Dyer Well
firm name

Sharky
county well located

LANDOWNER: William McKimney
Box 98
Anguilla Ms.
(mailing address)

description of formations encountered

from

to

WELL LOCATION:
sec. 27 T 13 N R 6 E
S W

CLAY	0	42
Fine Sand	42	68
M Sand & Gravel	68	76
Fine Sand	76	88
Sand & Gravel	88	98
Fine Sand	98	106
Sand & Gravel	106	135

_____ miles _____ of _____
(distance) (direction) (nearest town)

WELL PURPOSE: Fish Pond
(home, irrigation, municipal, industrial)

WELL COMPLETION DATA:

- (1) diameter (inches) 16"
- (2) total depth (feet) 135
- (3) static water level (feet) _____ below/above top of ground.
- (4) casing Steel (material), _____ (depth),
16" (size) if telescope see back.
- (5) screen 40' (length), _____ (depth to top),
16" (size), _____ (material)
- (6) pump _____ (HP), _____ (yield gpm),
_____ (type power)
- (7) electric log No (yes or no),
None (organization running log)
- (8) how well bottom plugged Plate

RECEIVED
JAN 01 1988


FEB 01 1988

Department of Natural Resources
Bureau of Land & Water Resources

DRILLERS REMARKS:

If well telescopes please sketch and show depths.

GROUND LEVEL

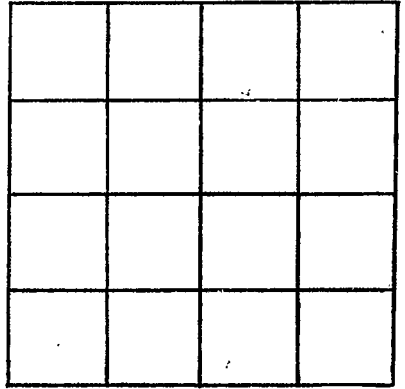

SECTION _____

Please indicate well location X.

ADDITIONAL INFORMATION

If more than one screen,
show locations of each on sketch.