

MISSISSIPPI DEPARTMENT OF ENVIRONMENTAL QUALITY

Office of Land and Water Resources

P. O. Box 10631
Jackson, MS 39289-0631
WATER WELL DRILLERS LOG

COUNTY WELL LOCATED <i>Sharkey</i>	
WELL NUMBER <i>C 126</i>	CODED <input checked="" type="checkbox"/>
DATE WELL COMPLETED <i>3-31-95</i>	

PERMIT NUMBER
NAME OF DRILLING FIRM <i>Schudco Ltd</i>

NAME & MAILING ADDRESS OF LANDOWNER <i>Bob Golitz</i>		
<i>Anguilla MS</i>		
WELL LOCATION: SEC	TOWNSHIP	RANGE
<i>18</i>	<i>13</i>	<i>N 6 E</i>
DISTANCE	DIRECTION	NEAREST TOWN
<i>1</i> Miles	<i>West</i> of	<i>Anguilla</i>
OTHER LANDMARK		
WELL PURPOSE: Home, Irrigation, Municipal, Industrial, Fish Pond, etc. <i>Shop</i>		

PUMP DATA		
PUMP TYPE (Circle One): <input checked="" type="checkbox"/> Submersible, Turbine, Jet, Flowing Well, Other (Describe) _____		
POWER TYPE (Circle One): <input checked="" type="checkbox"/> Electric, Tractor, Diesel, Gasoline, Butane, Other (Describe) _____ H/P <i>2</i>		
Pump Capacity (GPM) <i>35</i>	No. of Stages	Setting Depth <i>105</i> FT.
PUMP TEST		
Well yielded _____ GPM with a drawdown of _____ ft. after _____ hours of pumping		


WELL DATA		
Well Depth <i>415</i>	Casing Diameter (In.) <i>4x2</i>	Casing Length (Ft.)
Type of Casing <i>pvc</i>	Hole Depth <i>1200</i>	Depth to Static Water Level <i>15 ft</i>
TYPE OF COMPLETION: (Circle One or More): <input checked="" type="checkbox"/> Gravel Packed, Underreamed, Telescoped, <input checked="" type="checkbox"/> Natural Development, Open Hole, Other		
WELL GROUTED TO A DEPTH OF <i>10 FEET</i> Type Grout (circle one): Cement, Bentonite, or Mix <input checked="" type="checkbox"/>		

LOG DATA	
TYPE OF LOG RUN (Circle One): No Log Run, <input checked="" type="checkbox"/> Electric, Gamma Ray, Density, Sonic, Neutron, Other (Describe) _____	
Name of Organization Running Log	

SCREEN DATA		
Diameter - Inches <i>2</i>	Length - Feet <i>20</i>	Slot Size - Inches <i>.008</i>
Screen Type <i>pvc</i>	Depth to Bottom - Feet <i>415</i>	

GEOLOGIC DATA (Office Use Only)			
Surface Elev.	Geologic Unit	Unit Thickness	Depth to Top
Subs. SWL	Date	Analysis	Aquifer Test
Driller's Remarks			

DESCRIPTION OF FORMATIONS ENCOUNTERED	FROM	TO
<i>Top soil</i>	<i>0</i>	<i>6</i>
<i>Clay</i>	<i>6</i>	<i>44</i>
<i>sand + gravel</i>	<i>44</i>	<i>142</i>
<i>clay</i>	<i>142</i>	<i>240</i>
<i>sand</i>	<i>240</i>	<i>300</i>
<i>clay + shell</i>	<i>300</i>	<i>940</i>
<i>shell + sand streaks</i>	<i>940</i>	<i>1200</i>

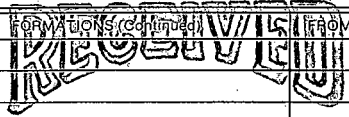

Dept. of Environmental Quality
Office of Land & Water Resources

IF MORE SPACE IS NEEDED, USE BACK

