

Martin #1

Biqo.

MISSISSIPPI DEPARTMENT OF ENVIRONMENTAL QUALITY  
Office of Land and Water Resources

P. O. Box 10631  
Jackson, MS 39289-0631  
WATER WELL DRILLERS LOG

COUNTY WELL LOCATED <u>Sharkey</u>	
WELL NUMBER <u>C-140</u>	CODED
DATE WELL COMPLETED <u>6-11-03</u>	

PERMIT NUMBER
NAME OF DRILLING FIRM <u>Chicot Irrigation</u>

NAME & MAILING ADDRESS OF LANDOWNER <u>CHRIS MARTIN</u> <u>P.O. Box 157</u> <u>ANGUILLA, MS. 38721</u>			
Latitude: <u>32 58 35 21</u>			
Longitude: <u>090 51 58 33</u>			
WELL LOCATION	SEC	TOWNSHIP	RANGE
<u>SW/NW</u>	<u>18</u>	<u>13</u>	<u>N 76 E</u>
DISTANCE	DIRECTION	NEAREST TOWN	
<u>2.6 Miles</u>	<u>west</u>	<u>of Anguilla</u>	
OTHER LANDMARK <u>Davis P.D. Air Port</u>			
WELL PURPOSE: Home <u>Irrigation</u> , Municipal, Industrial, Fish Pond, etc.			

PUMP DATA		
PUMP TYPE (Circle One): Submersible, <u>Turbine</u> , Jet, Flowing Well, Other (Describe)		
POWER TYPE (Circle One): Electric, Tractor, <u>Diesel</u> , Gasoline, Butane, Other (Describe) <u>H/P 40</u>		
DESCRIPTION OF FORMATIONS ENCOUNTERED	FROM	TO
<u>Top Soil</u>	<u>0</u>	<u>10</u>
<u>Gray Clay</u>	<u>10</u>	<u>40</u>
<u>Fine Sand</u>	<u>40</u>	<u>65</u>
<u>COARSE Sand</u>	<u>65</u>	<u>85</u>
<u>Fine Sand</u>	<u>85</u>	<u>90</u>
<u>COARSE Sand</u>	<u>90</u>	<u>100</u>
<u>Med. COARSE Sand</u>	<u>100</u>	<u>103</u>
<b>RECEIVED</b>		
<b>JUN 30 2003</b>		
<b>BY: OLWR</b>		
Top of Lap Pipe or Reduction in Casing		
FEET	IF TELESCOPED OR MORE THAN ONE SCREEN: USE BACK PAGE	

WELL DATA		
Well Depth <u>100</u>	Casing Diameter (In.) <u>10</u>	Casing Length (Ft.) <u>70</u>
Type of Casing <u>Pvc</u>	Hole Depth <u>103</u>	Depth to Static Water Level
TYPE OF COMPLETION: (Circle One or More): <u>Gravel Packed</u> , Underreamed, Telescoped, Natural Development, Open Hole, Other (Describe)		
WELL GROUTED TO A DEPTH OF <u>10</u> FEET Type Grout (circle one): Cement, <u>Bentonite</u> , or Mix		

SCREEN DATA		
Diameter - Inches <u>10</u>	Length - Feet <u>30</u>	Slot Size - Inches <u>051</u>
Screen Type <u>PVC</u>	Depth to Bottom - Feet <u>100</u>	

I certify that the well was drilled, constructed and completed in accordance with all applicable Requirements of the Mississippi Department of Environmental Quality and/or the Mississippi Department of Health regulations and state laws.


Gamer McDonald  
Signature of Licensed Driller and License No.

6/24/03  
Date

Additional Information Required On Back

If well telescopes please sketch and show depths.

GROUND LEVEL

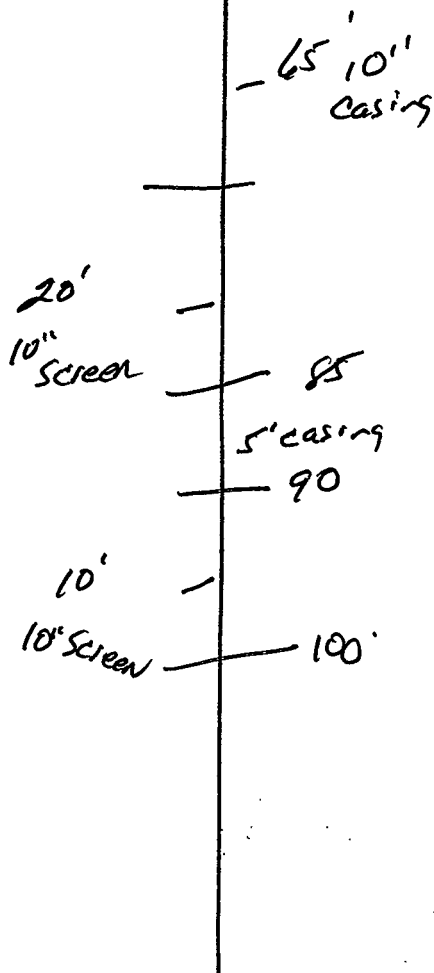

If more than one screen, show location of each on sketch.

X	18		

SECTION 18

Please indicate well location X.

Pump Capacity (GPM)	No. of Stages	Setting Depth
1200	2	60 FT.

PUMP TEST

Well yielded \_\_\_\_\_ GPM with a drawdown of \_\_\_\_\_ ft. after \_\_\_\_\_ hours of pumping

LOG DATA

TYPE OF LOG RUN (Circle One): No Log Run.  
 Electric, Gamma Ray, Density, Sonic, Neutron, Other (Describe) \_\_\_\_\_

Name of Organization Running Log \_\_\_\_\_

GEOLOGIC DATA (Office Use Only)

Surface Elev.	Geologic Unit	Unit Thickness	Depth to Top
Subs. SWL	Date	Analysis	Aquifer Test

Driller's Remarks

\_\_\_\_\_

\_\_\_\_\_

