

**B-C Farms
State Well Report**

Part 1

Mississippi Department of Environmental Quality
Office of Land and Water Resources
P.O. Box 10631
Jackson, MS 39289-0631
(601)961-5210
(601)354-6938 (fax)

For Office Use Only:

Aquifer: _____
Well #: C-158
L. S. Elevation: _____
E-log #: _____

County: SHARKEY
Permit #: 6W40276
Driller: J. NEWCOME
Date drilling completed: 2-20-07

State Law requires that this report be prepared by the driller in detail and filed with the Department within 30 days of completion of drilling of the well.

Well Owner Information	Well Location
Owner Name: <u>B-C Farms</u>	Latitude: <u>32° 58' 23"</u> Longitude: <u>90° 50' 58"</u>
Mailing Address: <u>C/O BRAD CLINKSCALES</u> <u>837 FRONT ST.</u> <u>ANGUILA MS. 38721</u> City State Zip Code	Method of Lat/Long (circle one): Conventional Survey, USGS quad, <u>(Hand-held GPS)</u> Survey-grade GPS <u>SW</u> <u>NE</u> <u>SE</u> <u>SW</u> 1/4 Sec <u>18</u> Twn <u>12N</u> Rng <u>6W</u>
Telephone No: <u>662-907-7561</u>	Distance: <u>2.2</u> Miles Direction: <u>SW</u> of Nearest Town: <u>Anguilla MS</u>

Well Data

Purpose of Well (circle one) Home Industrial Public Supply Irrigation Fish Culture Other: _____

Date well drilling started: 2-20-07 Date well drilling completed: 2-20-07

If flowing, method of flow regulation: Valve _____ Other (describe) _____

Static Water Level: _____ feet above or below (circle one) land surface Date measured: _____

Method of Measurement (circle one) steel tape electric tape air line other: _____

Hole depth: 123 Well depth: 120 Well grouted to a depth of 10 feet

Type of grout (circle one): Cement Bentonite Mix

Casing length: 90 feet Casing diameter: 10 inches Type of casing: PVC

Screen length: 30 feet Screen diameter: 10 inches Type of screen: PVC

Screen slot size: 050 inches Setting depth: From 80-95 feet to 105-120 feet

Type of completion (circle all applicable): Gravel packed Underreamed Telescoped Open hole Natural Development:
Other (describe): _____

Top of lap pipe or reduction in casing: _____ feet. If telescoped or more than one screen, describe on back of page

Logs run (circle all applicable): No log run Electric Gamma Ray Density Sonic Neutron Other: _____

Name of organization running log(s): _____

I certify that the well was drilled, constructed, and completed in accordance with all applicable requirements of the Mississippi Department of Environmental Quality and/or the Mississippi Department of Health regulations and state laws.

JOHN NEWCOME 0-773
Print Name of Water Well Contractor and License No.

[Signature]
Signature of Water Well Contractor


RECEIVED

MAR 16 2007
BY: OLWR

If well telescopes please sketch below and show depths.

C-1


Ground Level

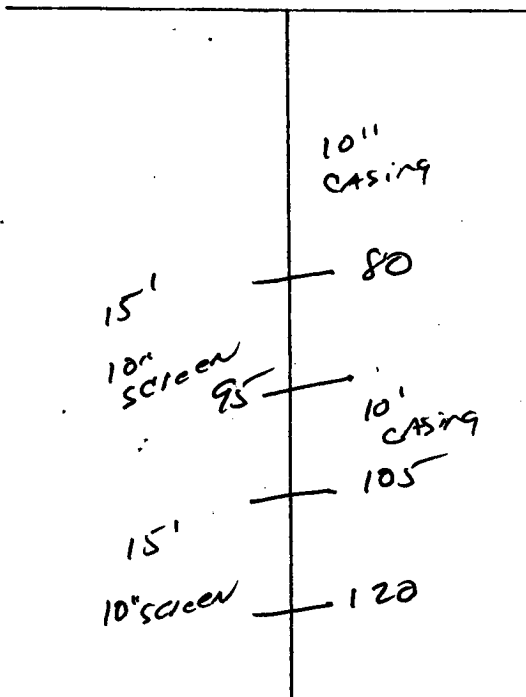

Description of Formations Encountered	From	To
Top Soil	0	10
Mix CLAY	10	28
	28	

If more than one screen, show location of each on sketch

Sketch the property layout and include the following: 1) the well location; 2) any permanent structures on the property that may aid in locating the well; 3) any roads, power lines, or other items that may aid in locating the property and the well; 4) indicate direction.

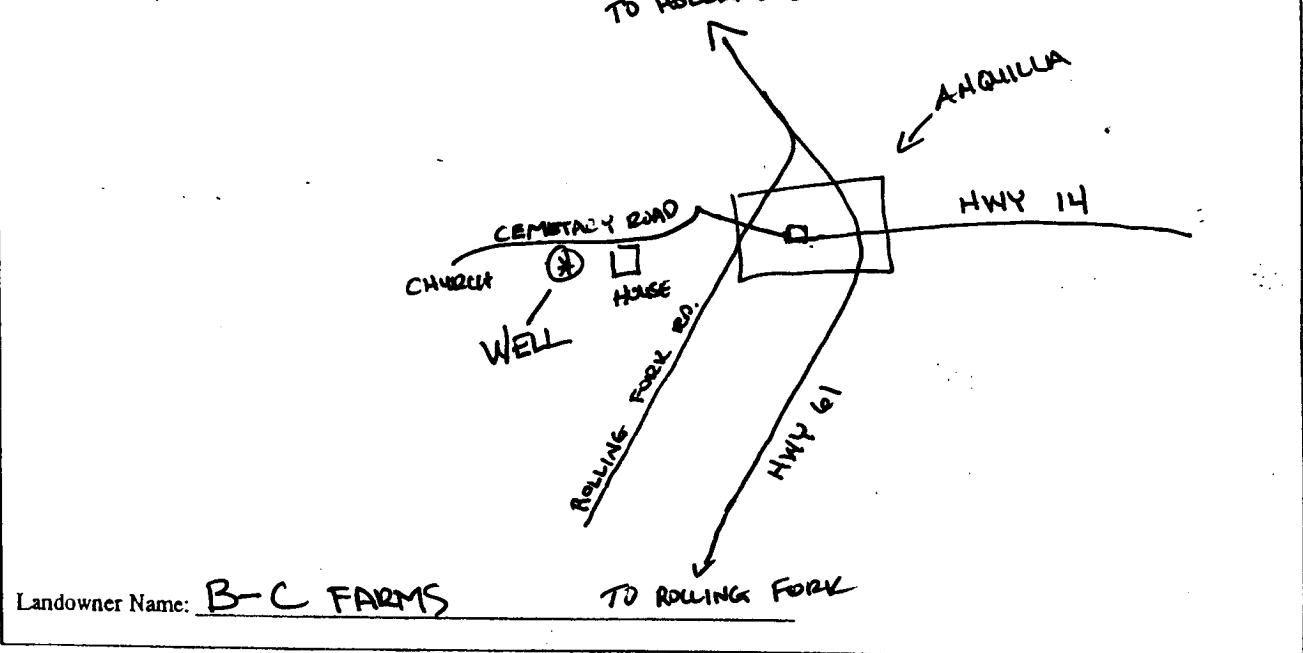

Landowner Name: B-C FARMS

[Handwritten Signature]
Signature of Water Well Contractor

STATE WELL REPORT

Part 2

Pump Installer's Completion Report
 Mississippi Department of Environmental Quality
 Office of Land and Water Resources
 P.O. Box 10631
 Jackson, MS 39289-0631
 (601)961-5210
 (601)354-6938 (fax)

For Office Use Only:

Aquifer: _____

Well #: C-158

Elevation: _____

County: SHARKEY
 Permit #: 6W40276
 Driller: J. NEW COMBE
 Date completed: 2/20/07

This report should be prepared by the pump installer in detail and filed with the Department within 30 days of the installation of pump.

Well Owner Information	Well Location
Owner Name: <u>B & C Farms</u>	Latitude: <u>32-58-23</u> Longitude: <u>090-50-58</u>
Mailing Address: <u>c/o BRAD CLINKSCALES</u> <u>837 FRONT ST.</u> <u>ANDQUICA, MS. 38721</u>	Method of Lat/Long (circle one): Conventional Survey, USGS quad, <u>Hand-held GPS</u> Survey-grade GPS
City: _____ State: _____ Zip Code: _____	<u>NE</u> ¼ <u>SE</u> ¼ Sec <u>18</u> Twn <u>13N</u> Rng <u>6W</u>
Telephone No: <u>662-907-2561</u>	Distance _____ Direction _____ Nearest Town _____
	<u>2.2</u> Miles <u>SW</u> of <u>ANDQUICA, MS.</u>

Pump Type Circle one	Power Type Circle one
Air Lift _____ Jet _____ <u>Submersible</u>	Diesel Engine _____ Gasoline Engine _____ Natural Gas _____
Bucket _____ Piston _____ Turbine _____	<u>Electric Motor</u> _____ Hand _____ Tractor PTO _____
Centrifugal _____ Rotary _____ Flowing Well _____	Windmill _____ Other (specify): _____
Other (specify): _____	Horse Power Rating of Motor: <u>15HP 1-PHASE</u>
Date Pump Installed: <u>2/21/07</u>	Setting Depth: <u>70</u> feet
Rated Pump Capacity: <u>900</u> Gallons Per Minute	Number of Stages: <u>1</u>

Pump Test Data	Method of Measuring Water Level Circle one
Date Well Tested: <u>NOT TESTED</u>	Air Line _____ Electric Measuring Line _____ Steel Tape _____
Static Water Level (A): _____ Feet Below Land Surface	Other (specify): _____
Pumping Water Level (B): _____ Feet Below Land Surface	For flowing well, measured shut in head: _____ feet
Drawdown [(B) - (A)]: _____ Feet Below Land Surface	Well yielded _____ GPM with a drawdown of _____ feet after _____ hours of pumping
Test Pumping Rate: _____ Gallons Per Minute	
Duration of Pump Test (minimum 4 hours): _____ hours	

I HEREBY CERTIFY that the above statements are true to the best of my knowledge.

GLEN ROWE #710P
 Print Name of Pump Installer and License No. (if applicable)

[Signature]
 Signature of Pump Installer

RECEIVED
 MAR 16 2007
 BY: OLWR