

MARTIN Farms
State Well Report

Part 1

Mississippi Department of Environmental Quality
 Office of Land and Water Resources
 P.O. Box 10631
 Jackson, MS 39289-0631
 (601)961-5210
 (601)354-6938 (fax)

For Office Use Only:

Aquifer: C 185
 Well #: _____
 L. S. Elevation: _____
 E-log #: _____

County: SHARKEY
 Permit #: 6W 43851
 Driller: J. NEWCOME 0-773
 Date drilling completed: 4-12-10

State Law requires that this report be prepared by the driller in detail and filed with the Department within 30 days of completion of drilling of the well.

Well Owner Information	Well Location
Owner Name: <u>Sandy Bayou Farms</u>	Latitude: <u>32.57.03</u> Longitude: <u>90.57.30</u>
Mailing Address: <u>5415 Sandy Bayou Rd</u>	Method of Lat/Long (circle one): Conventional Survey.
<u>Rolling Fork MS 39159</u>	USGS quad: <u>Hand-held GPS</u> Survey-grade GPS
City State Zip Code	NW 1/4 SE 1/4 Sec <u>30</u> Twn <u>13N</u> Rng <u>6W</u>
Telephone No. ()	Distance <u>2.7</u> Miles Direction <u>Northwest</u> of Nearest Town <u>Rolling Fork</u>

Well Data

Purpose of Well (circle one) Home Industrial Public Supply Irrigation Fish Culture Other: _____

Date well drilling started: 4-12-10 Date well drilling completed: 4-12-10

If flowing, method of flow regulation: Valve _____ Other (describe) _____

Static Water Level: _____ feet above or below (circle one) land surface Date measured: _____

Method of Measurement (circle one) steel tape electric tape air line other: _____

Hole depth: 123 Well depth: 120 Well grouted to a depth of 10 feet

Type of grout (circle one): Cement Bentonite Mix

Casing length: 80 feet Casing diameter: 16 inches Type of casing: PVC

Screen length: 40 feet Screen diameter: 16 inches Type of screen: PVC

Screen slot size: .050 inches Setting depth: From 80 feet to 120 feet

Type of completion (circle all applicable): Gravel packed Underreamed Telescoped Open hole Natural Development

Other (describe): _____

Top of lap pipe or reduction in casing: _____ feet. If telescoped or more than one screen, describe on back of page

Logs run (circle all applicable): No log run Electric Gamma Ray Density Sonic Neutron Other: _____

Name of organization running log(s): _____


I certify that the well was drilled, constructed, and completed in accordance with all applicable requirements of the Mississippi Department of Environmental Quality and/or the Mississippi Department of Health regulations and state laws.

JOHN NEWCOME 0-773
 Print Name of Water Well Contractor and License No.

[Signature]
 Signature of Water Well Contractor

RECEIVED
 AUG 16 2010
 BY: OLWR

If well telescopes please sketch below and show depths.

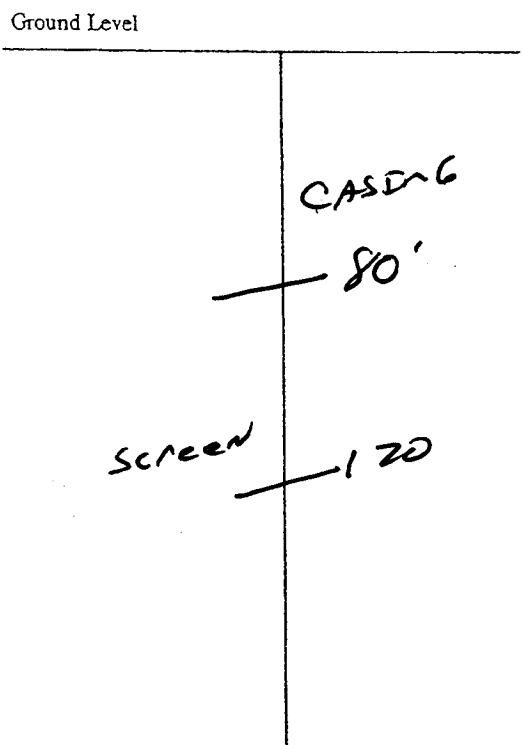

Description of Formations Encountered	From	To
TOP Soil	0	10
MIX CLAY	10	18
Med. Fine Sand	18	80
COARSE Sand	80	120
Gravel	120	123

If more than one screen, show location of each on sketch

Sketch the property layout and include the following: 1) the well location; 2) any permanent structures on the property that may aid in locating the well; 3) any roads, power lines, or other items that may aid in locating the property and the well; 4) indicate direction.

A hand-drawn sketch of a property layout. At the top, a horizontal line represents a road, labeled "Hwy 61". An arrow on the left points towards "ANQUILA" and "N". An arrow on the right points towards "Rolling Fork" and "S". Below the road, a vertical line is labeled "MOUNTAIN RD". A horizontal line below that is labeled "OLD HIGHWAY". A well is marked with a star and labeled "WELL". A house is indicated by an arrow and labeled "House". A structure is labeled "CN". A hill is labeled "MT HEIGNA". At the bottom, a house is circled and labeled "BIG House on hill".

Landowner Name: _____

John Newane
Signature of Water Well Contractor

STATE WELL REPORT

Part 2

Pump Installer's Completion Report
 Mississippi Department of Environmental Quality
 Office of Land and Water Resources
 P.O. Box 10631
 Jackson, MS 39289-0631
 (601)961-5210
 (601)354-6938 (fax)

For Office Use Only:

Aquifer: C 185
 Well #: _____
 Elevation: _____

County: Sharkey
 Permit #: GW43851
 Driller: J. Newcome 0-773
 Date completed: 4-12-10

This report should be prepared by the pump installer in detail and filed with the Department within 30 days of the installation of pump.

Well-Owner Information	Well Location
Owner Name: <u>Sandy Bayou Farms</u>	Latitude: <u>32° 51' 03"</u> Longitude: <u>90° 51' 30"</u>
Mailing Address: <u>5415 Sandy Bayou Rd.</u>	Method of Lat/Long (circle one): Conventional Survey, USGS quad, <u>Hand-held GPS</u> , Survey-grade GPS
<u>Rolling Fork, MS 39159</u> City State Zip Code	<u>NW</u> ¼ <u>SE</u> ¼ Sec <u>19</u> Twn <u>3N</u> Rng <u>6W</u>
Telephone No. () _____	Distance Direction Nearest Town <u>2.7</u> Miles <u>NW</u> of <u>Rolling Fork</u>

Pump Type Circle one	Power Type Circle one
Air Lift Jet Submersible	<u>Diesel Engine</u> Gasoline Engine Natural Gas
Bucket Piston <u>Turbine</u>	Electric Motor Hand Tractor PTO
Centrifugal Rotary Flowing Well	Windmill Other (specify): _____
Other (specify): _____	Horse Power Rating of Motor: <u>60</u>
Date Pump Installed: <u>4/14/10</u>	Setting Depth: <u>70</u> feet
Rated Pump Capacity: <u>2800</u> Gallons Per Minute	Number of Stages: <u>1</u>

Pump Test Data	Method of Measuring Water Level Circle one
Date Well Tested: _____	Air Line Electric Measuring Line Steel Tape
Static Water Level (A): _____ Feet Below Land Surface	Other (specify): _____
Pumping Water Level (B): _____ Feet Below Land Surface	For flowing well, measured shut in head: _____ feet
Drawdown [(B) - (A)]: _____ Feet Below Land Surface	Well yielded _____ GPM with a drawdown of _____ feet after _____ hours of pumping
Test Pumping Rate: _____ Gallons Per Minute	
Duration of Pump Test (minimum 4 hours): _____ hours	

I HEREBY CERTIFY that the above statements are true to the best of my knowledge.

Cony Rowe 0-711P
 Print Name of Pump Installer and License No. (if applicable)

[Signature]
 Signature of Pump Installer

RECEIVED

AUG 16 2010

BY: OLWR